

SUITE: 1400



RSF: 23,516

AS-BUILT CONFIGURATION

OFFICES.....	37
RECEPTION.....	1
CONFERENCE ROOMS.....	5
KITCHEN.....	2
OPEN WORK AREA.....	+/-58

Not to scale, furniture and appliances not included

KEY PLAN

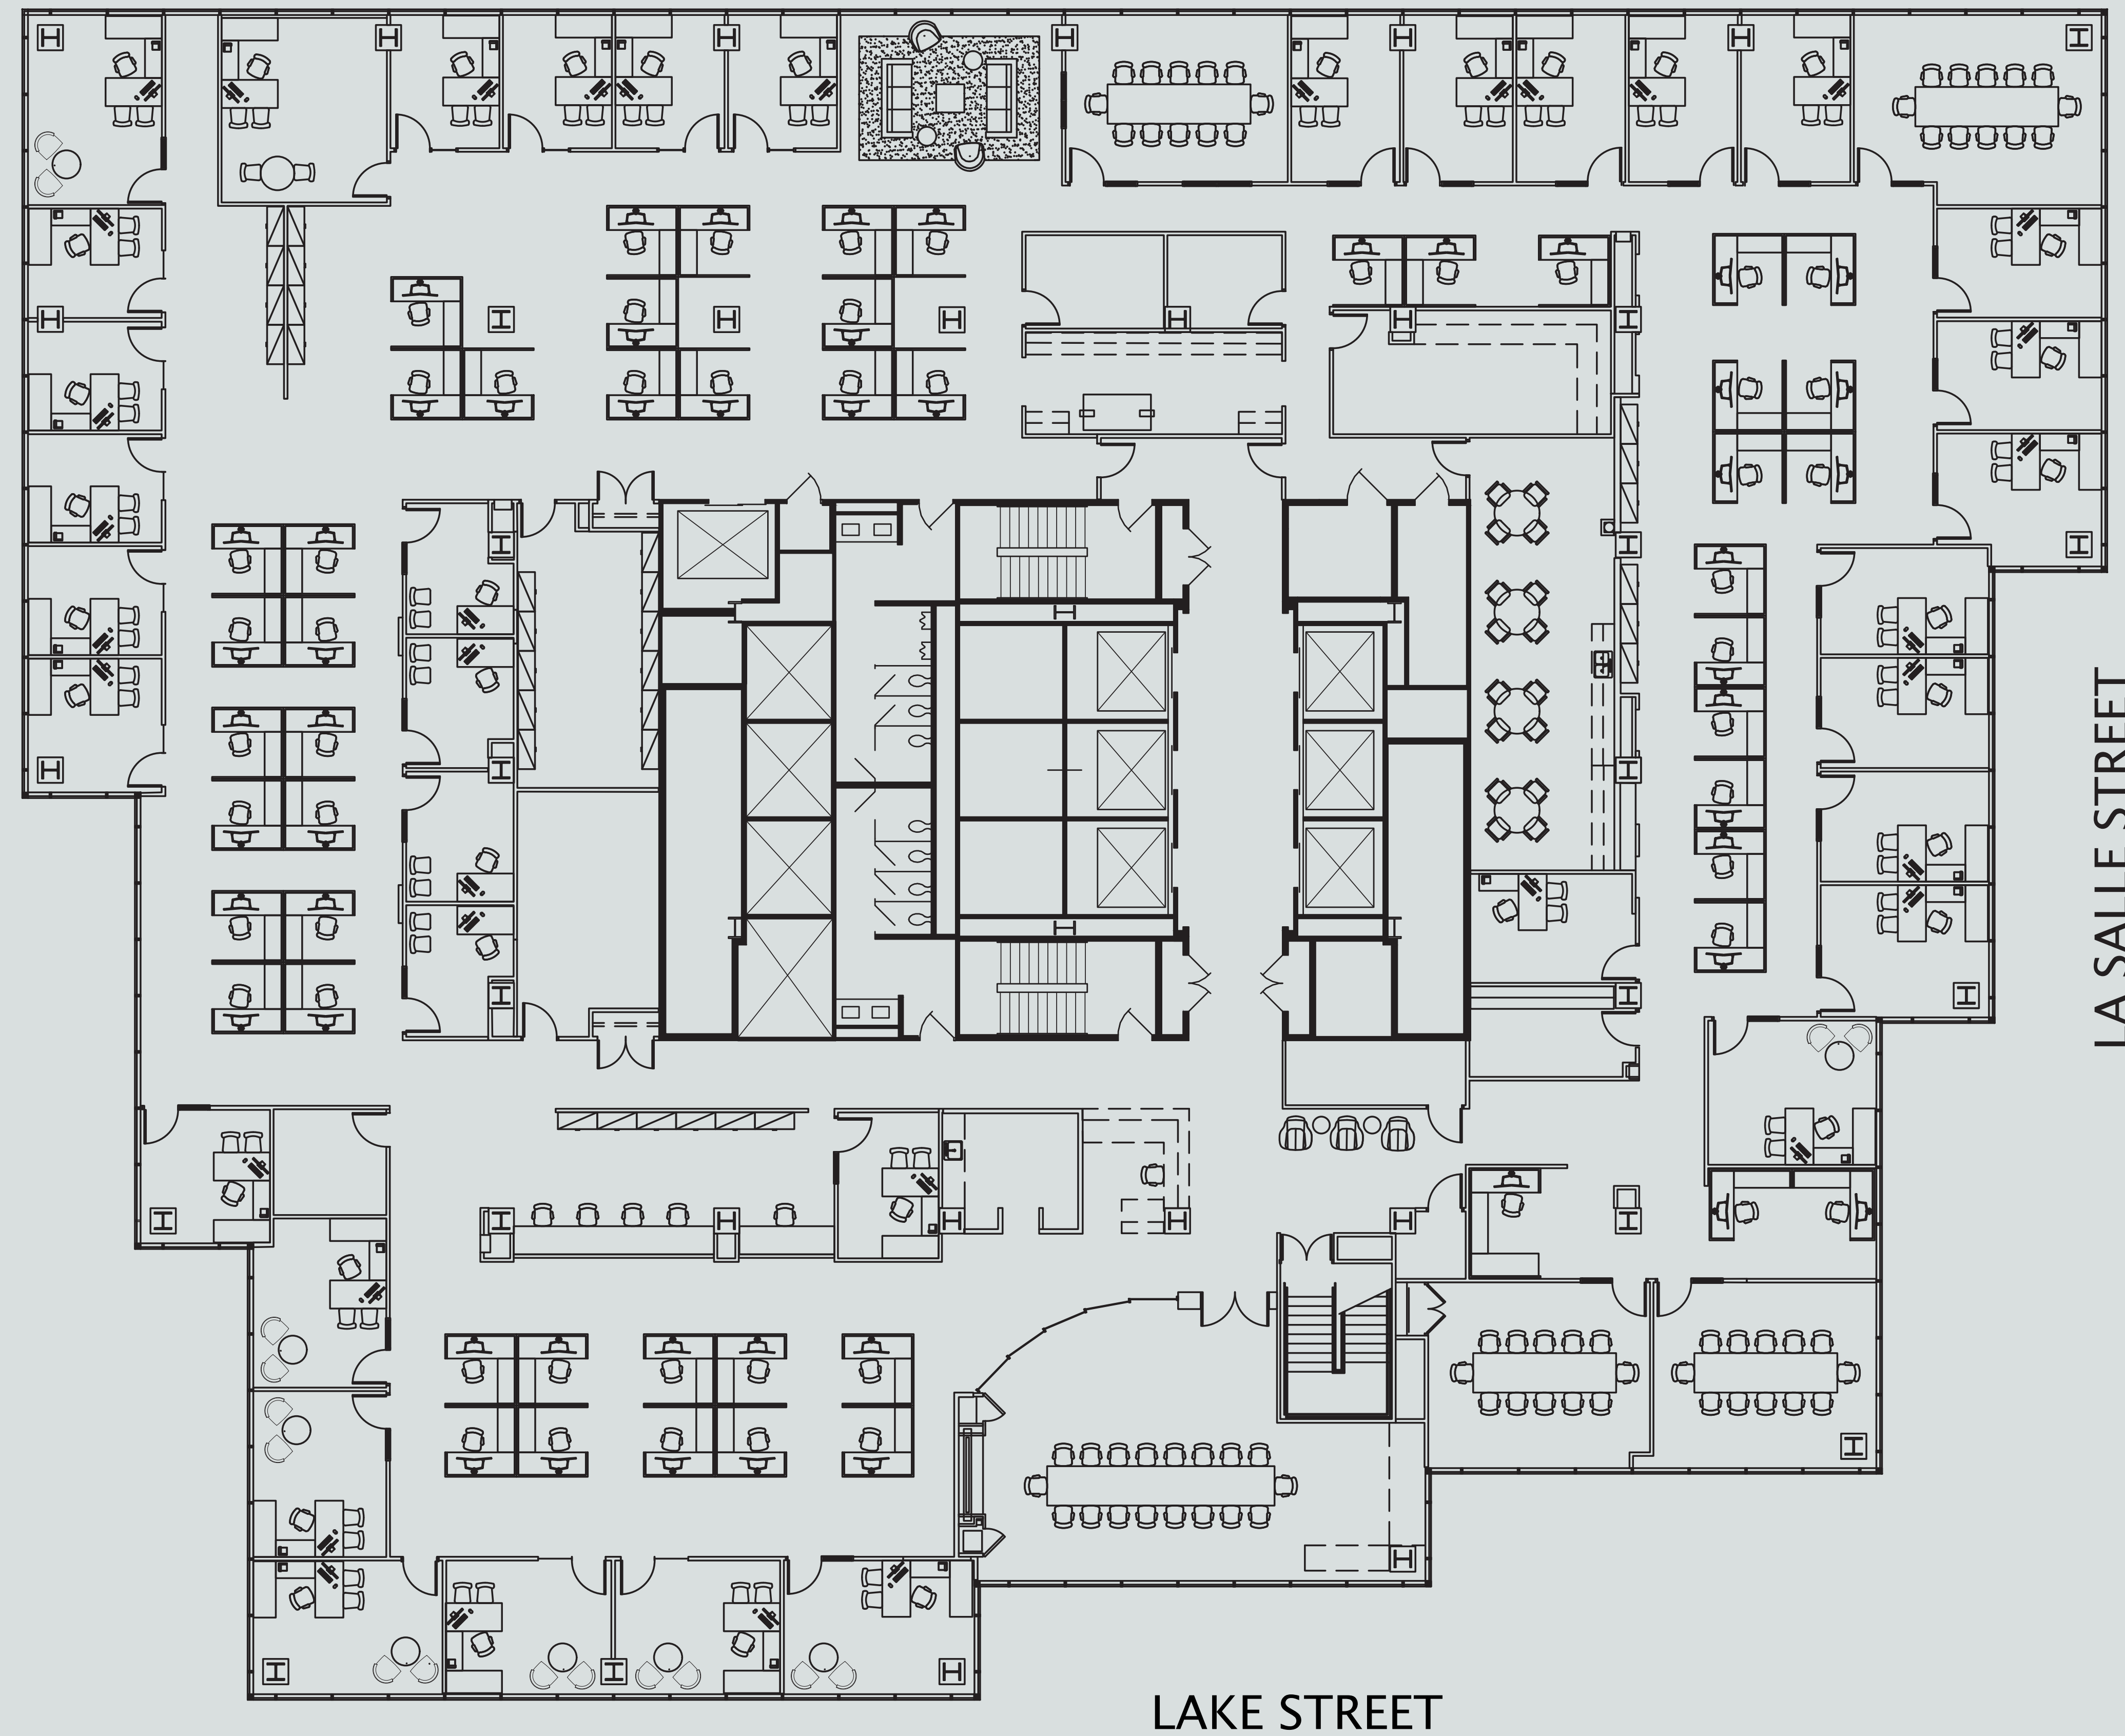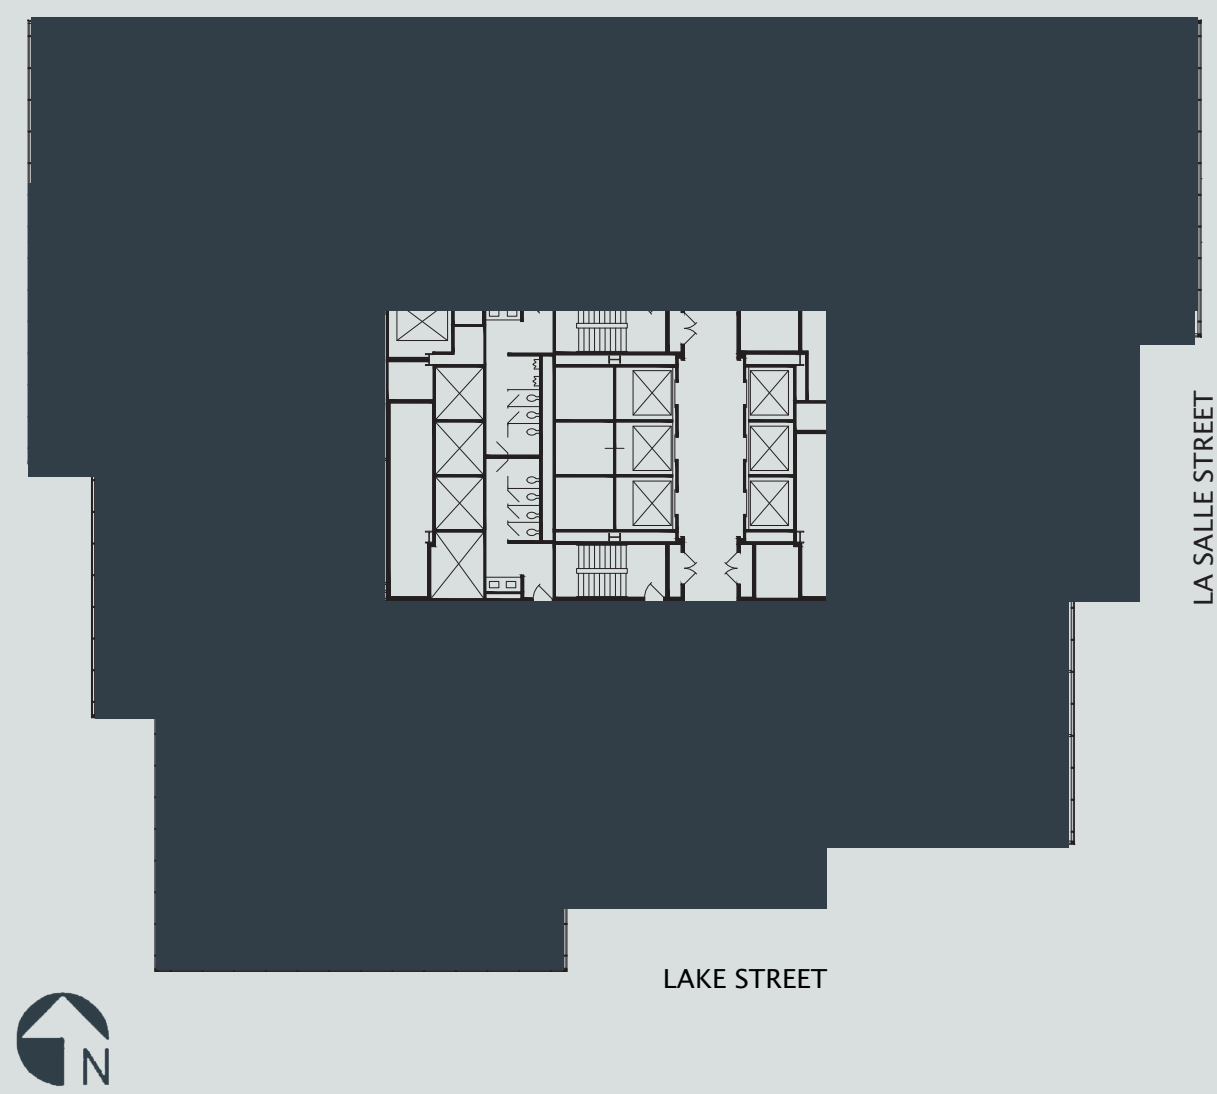

For leasing information please contact:
Mark J. Gunderson
312.448.8645 | mark.gunderson@streamrealty.com

Ben Cleveland
312 448.6221 | ben.cleveland@streamrealty.com