

SUITE: 1600


RSF: 23,149

AS-BUILT CONFIGURATION

| | |
|-----------------------|--------|
| OFFICES..... | 47 |
| RECEPTION..... | 1 |
| CONFERENCE ROOMS..... | 6 |
| KITCHEN..... | 2 |
| OPEN WORK AREA..... | +/- 30 |

Not to scale, furniture and appliances not included

KEY PLAN

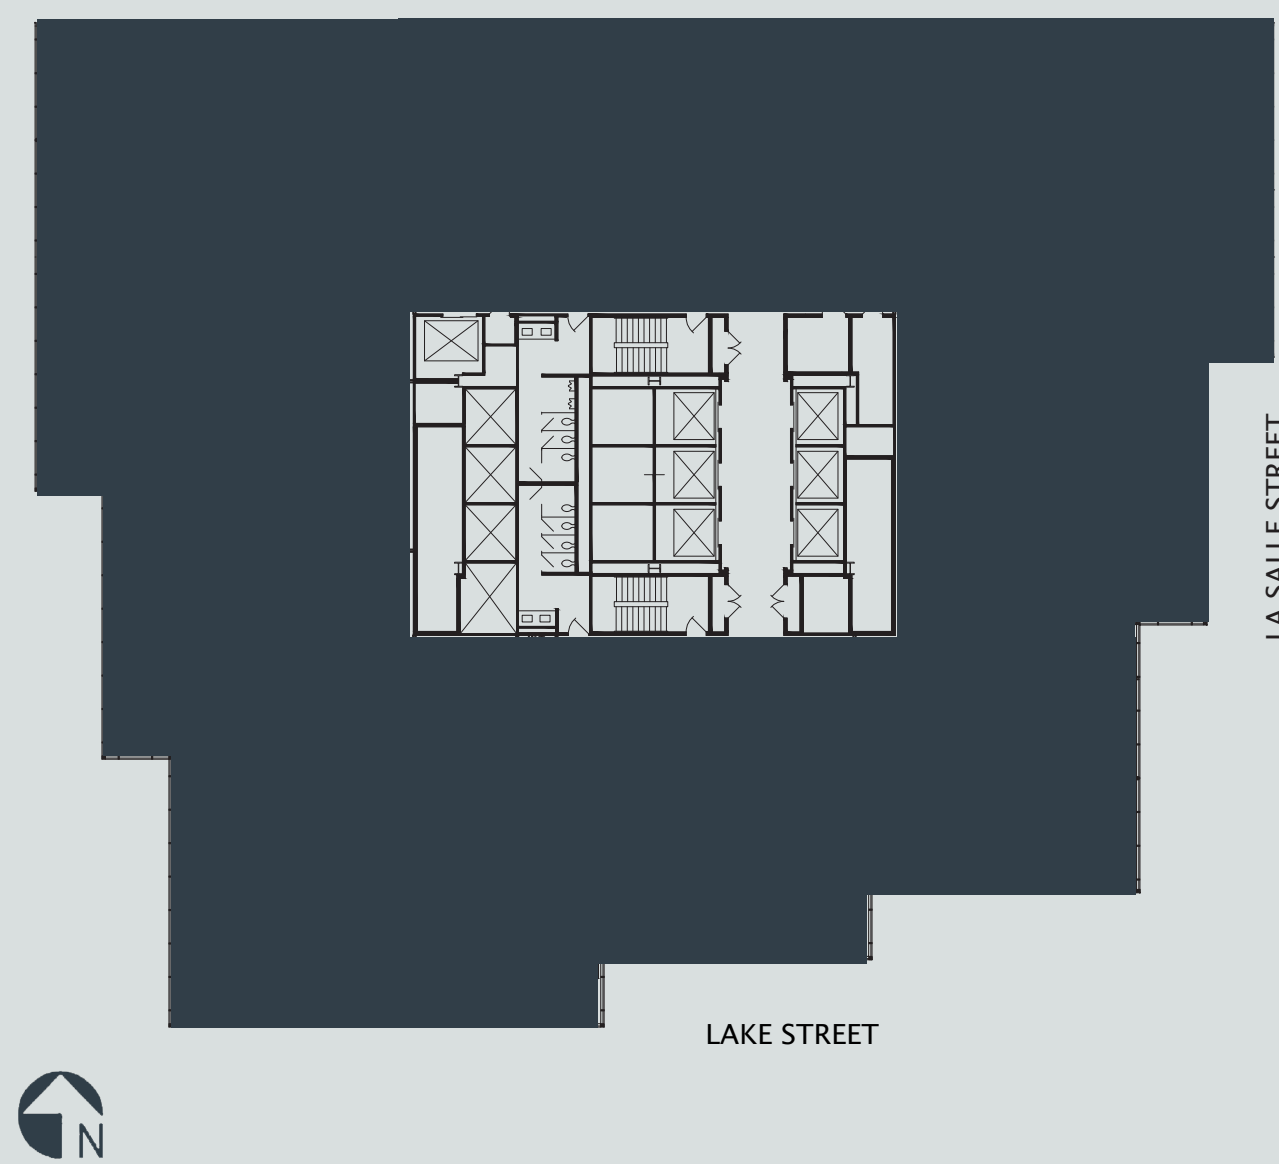

For leasing information please contact:
Mark J. Gunderson
312.448.8645 | mark.gunderson@streamrealty.com

Ben Cleveland
312 448.6221 | ben.cleveland@streamrealty.com