
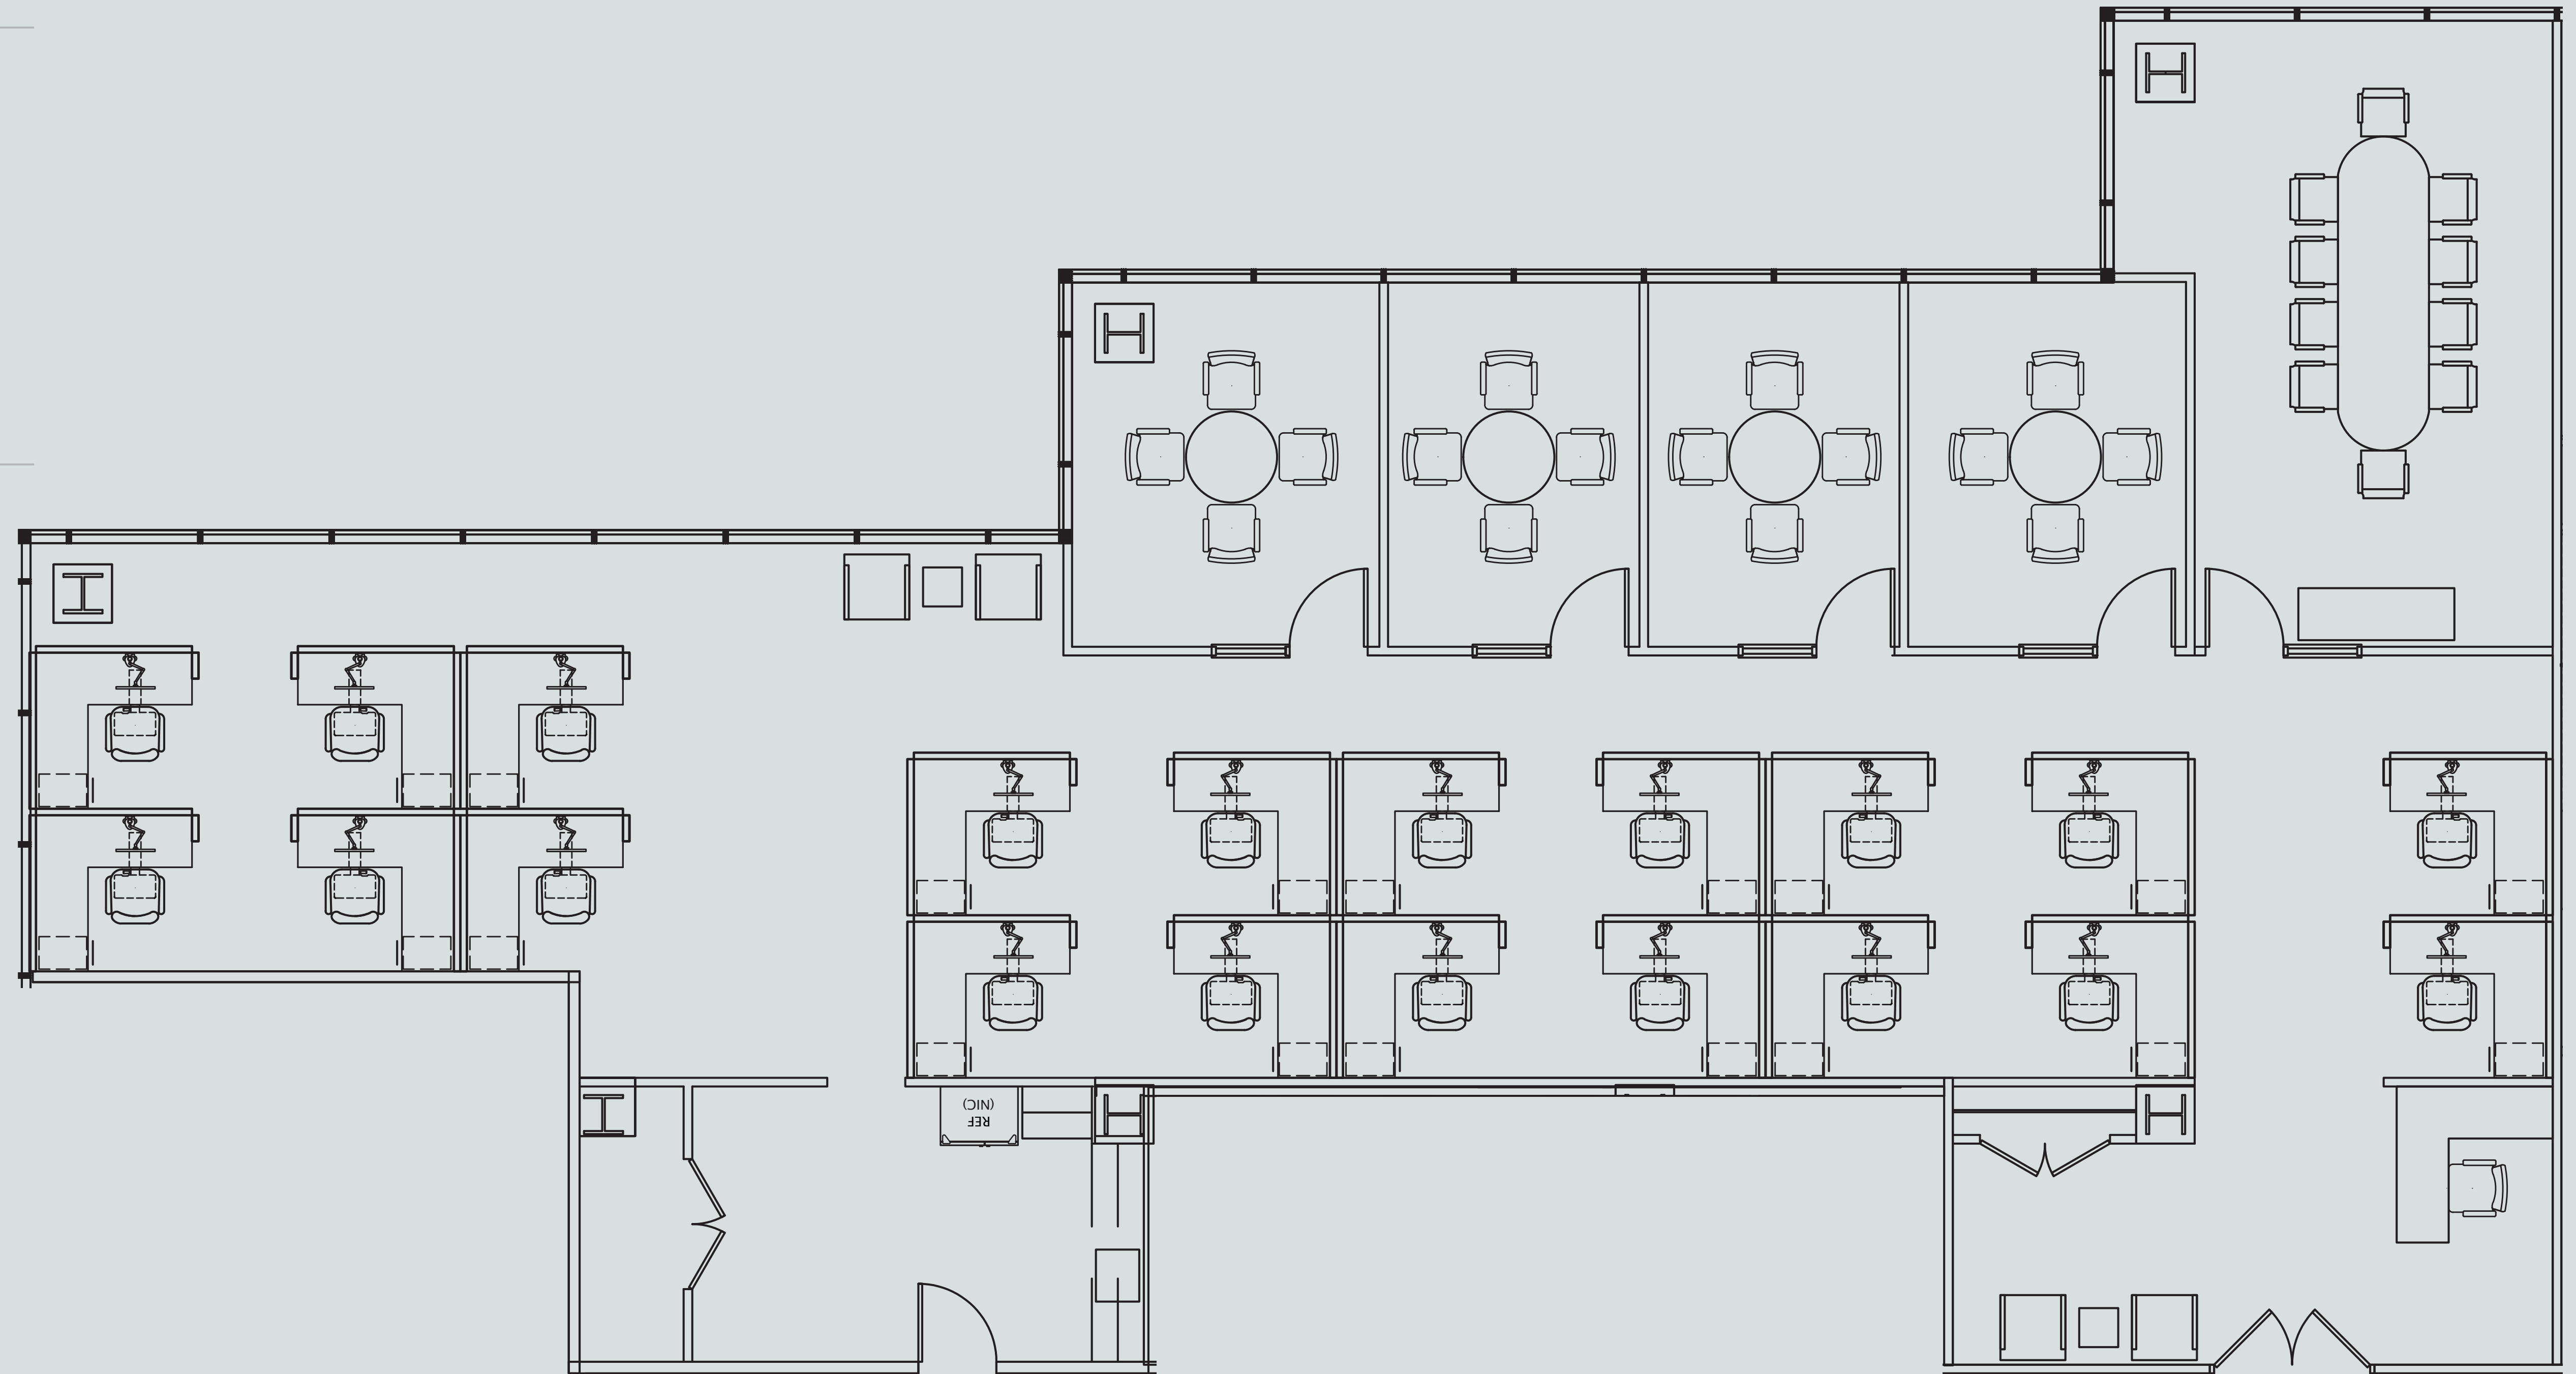


AS-BUILT CONFIGURATION

OFFICES.....	N/A
RECEPTION.....	1
CONFERENCE ROOMS.....	5
KITCHEN.....	1
OPEN WORK AREA.....	+/- 20

Not to scale, furniture and appliances not included

KEY PLAN

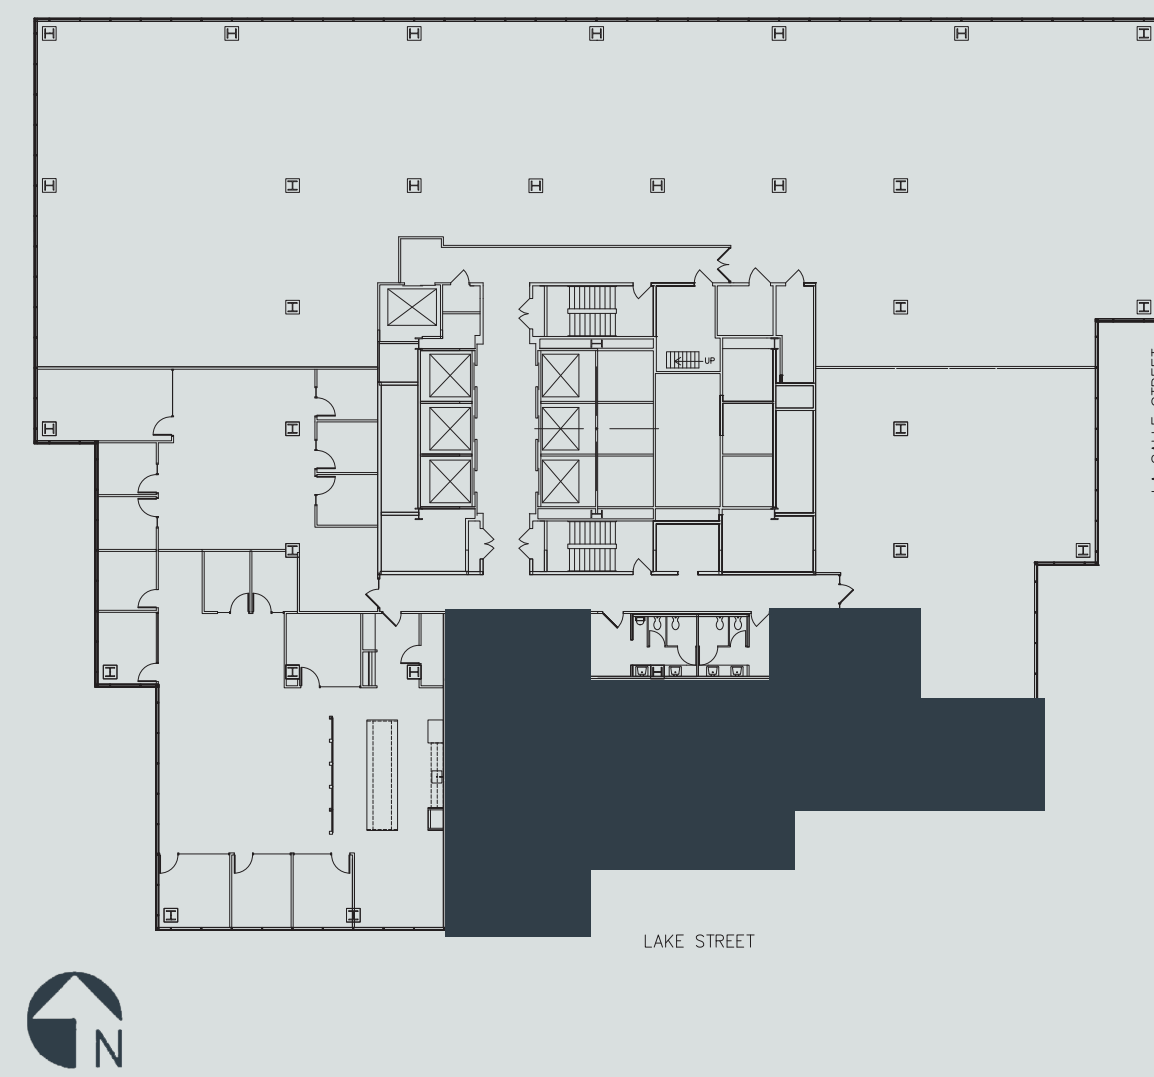

For leasing information please contact:
Mark J. Gunderson
3312.448.8645
mark.gunderson@streamrealty.com

Ben Cleveland
312.448.6221
ben.cleveland@streamrealty.com