

# SUITE: 1880



# RSF: 3,617

## AS-BUILT CONFIGURATION

OFFICES.....	7
RECEPTION.....	1
CONFERENCE ROOMS.....	1
KITCHEN.....	1
OPEN WORK AREA.....	+/- 14

*Not to scale, furniture and appliances not included*

## KEY PLAN

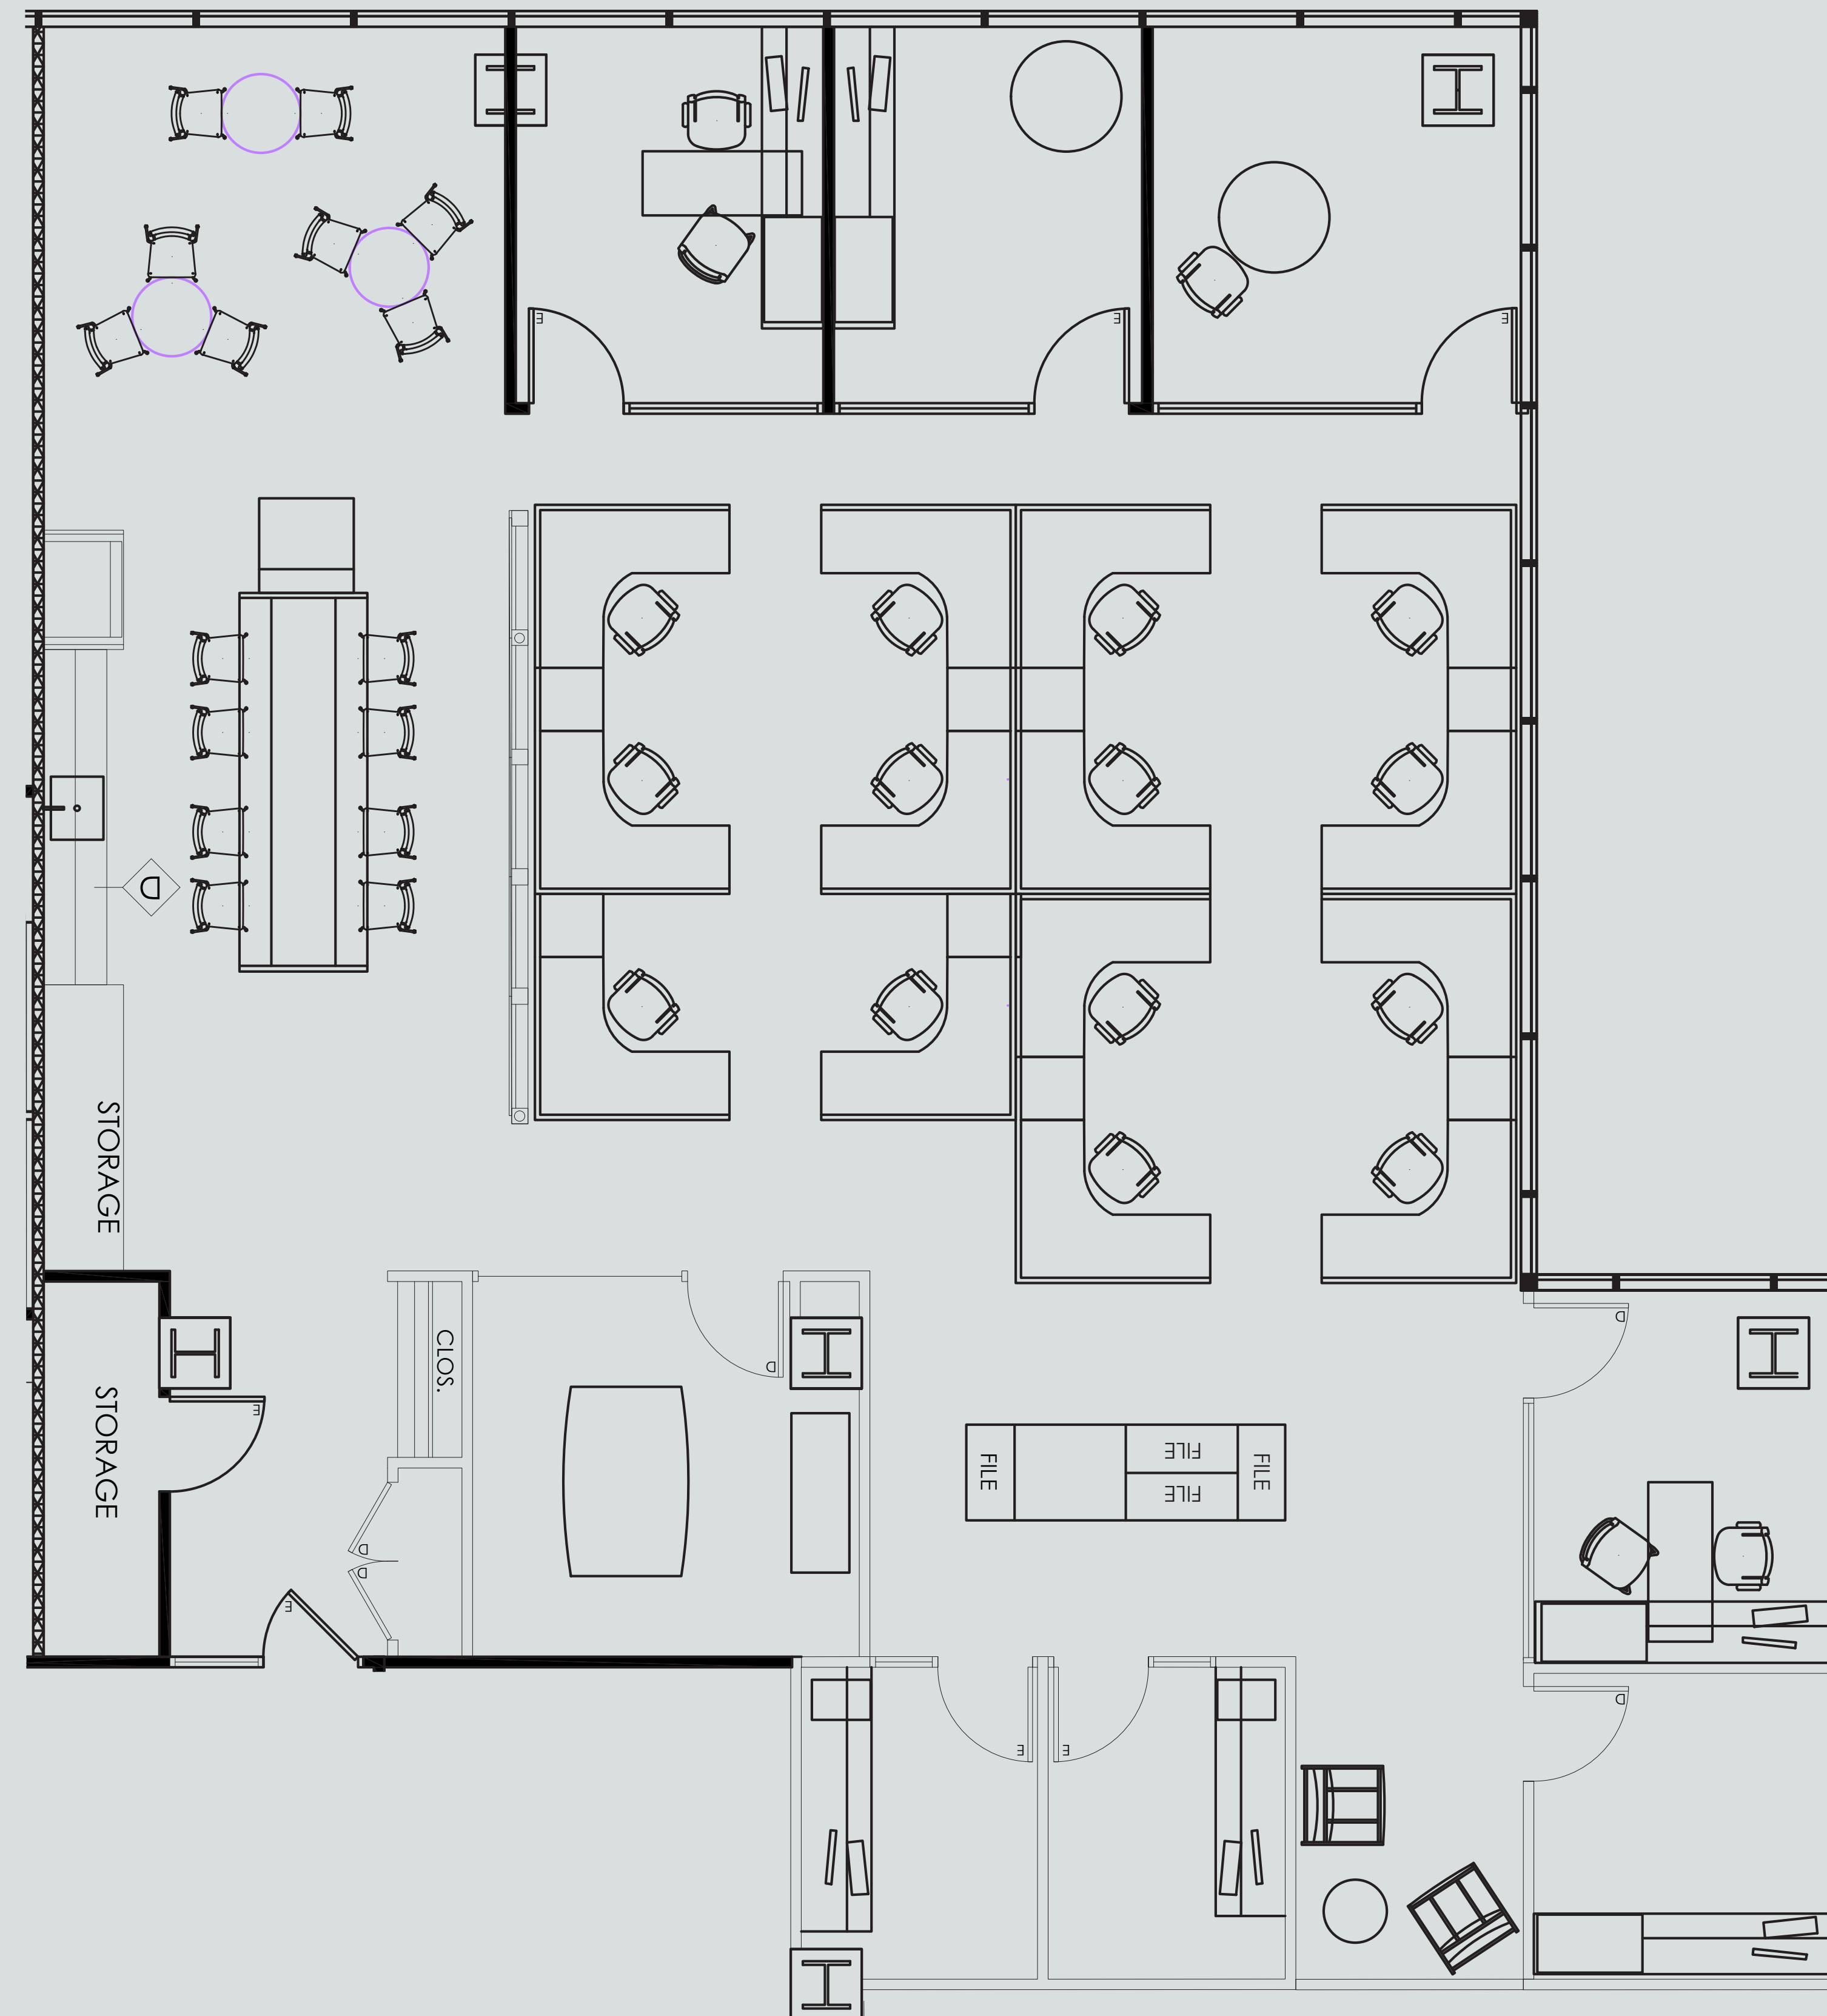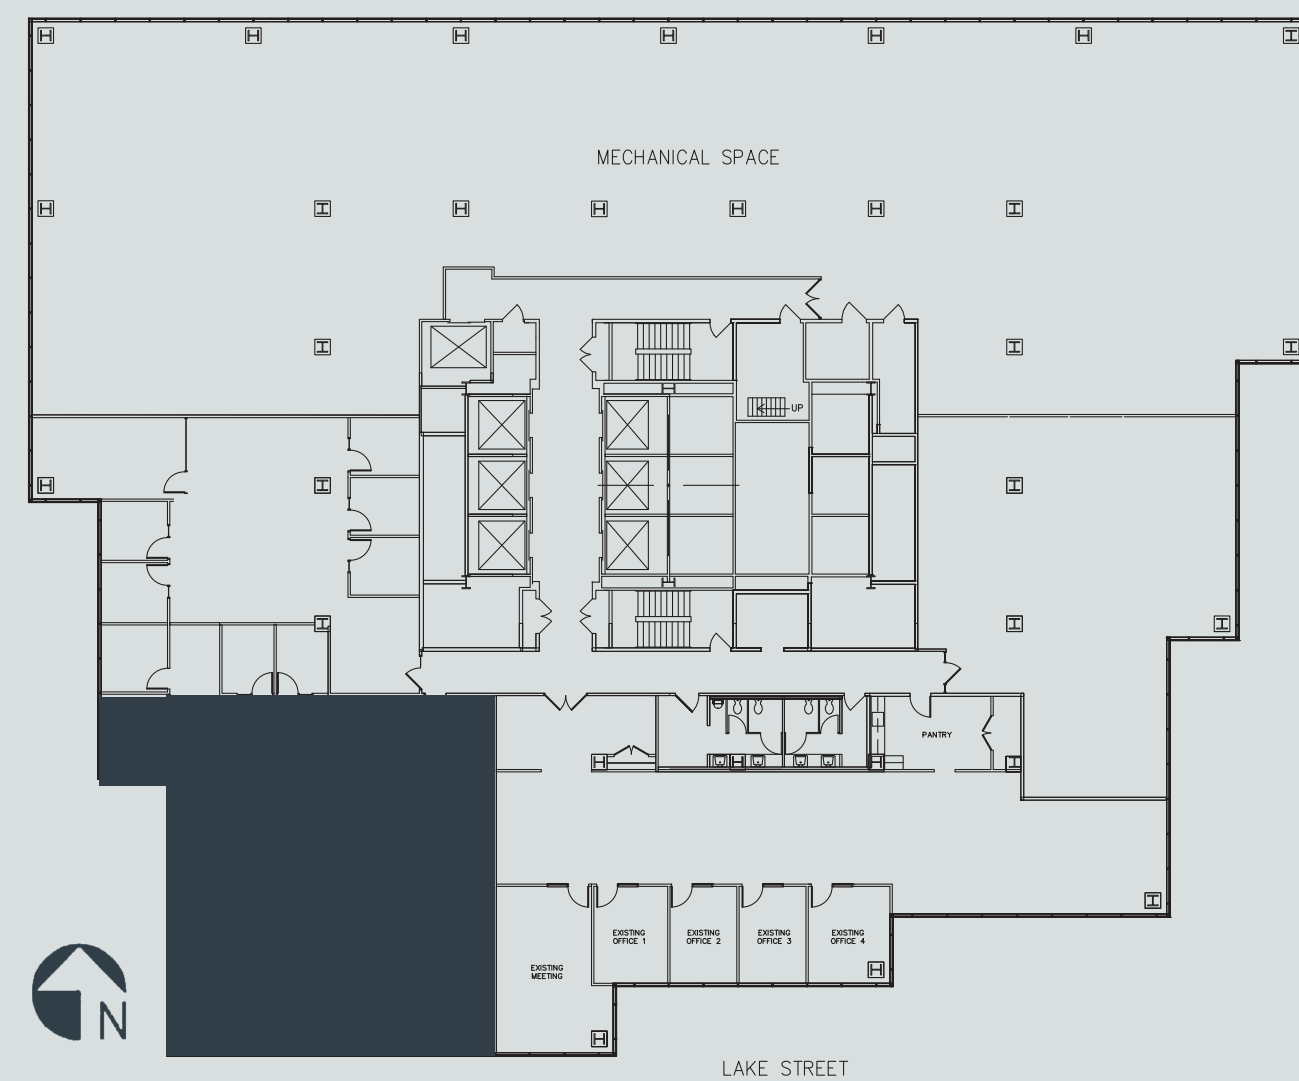

For leasing information please contact:  
Mark J. Gunderson  
312.448.8645 | mark.gunderson@streamrealty.com

Ben Cleveland  
312 448.6221 | ben.cleveland@streamrealty.com