

AS-BUILT CONFIGURATION

OFFICES..... N/A

RECEPTION..... N/A

 

CONFERENCE ROOMS..... N/A

KITCHEN..... N/A

OPEN WORK AREA.....N/A

Not to scale, furniture and appliances not included

KEY PLAN

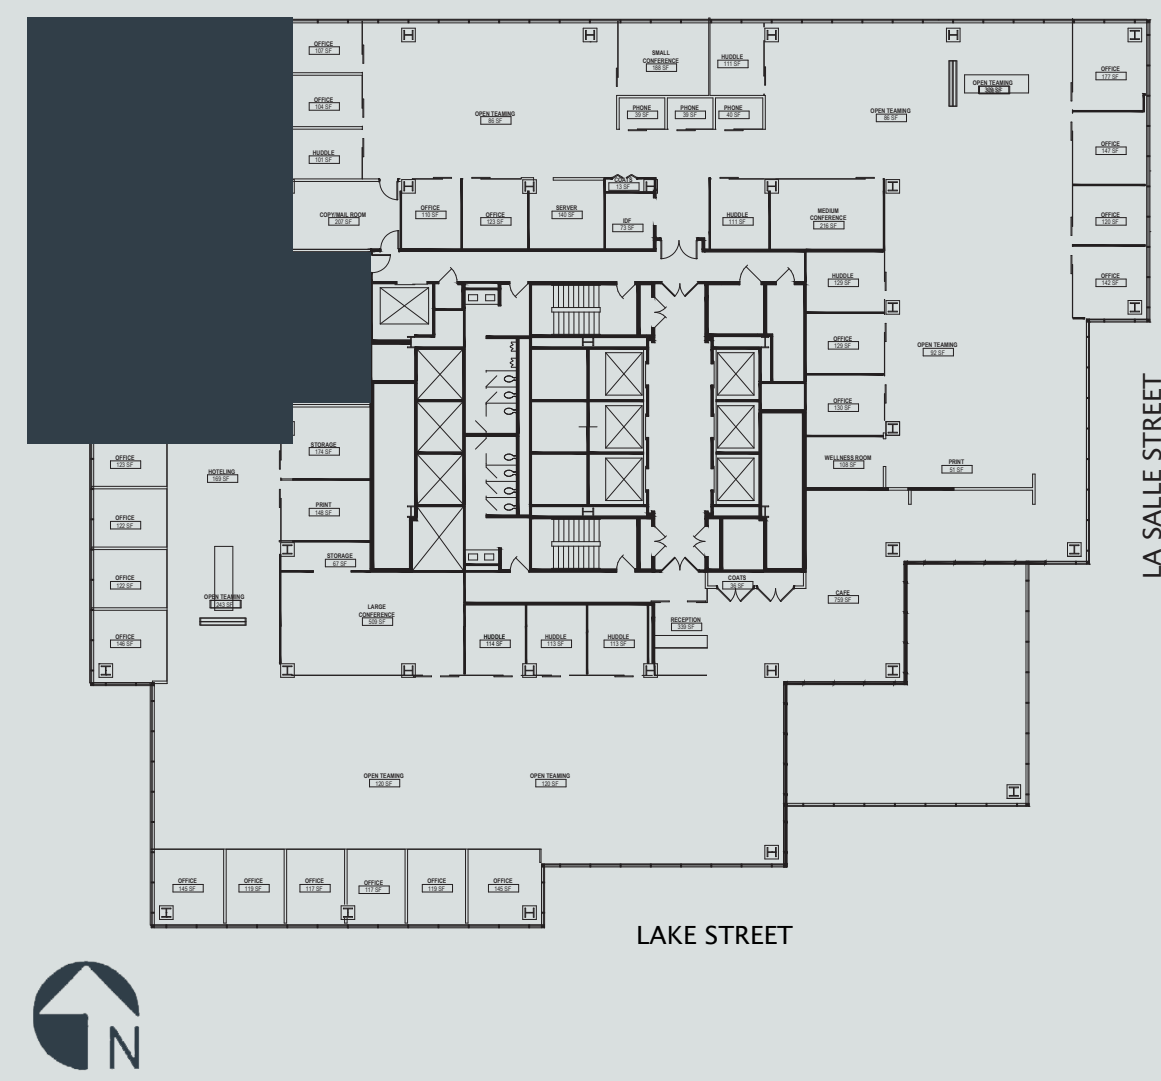

For leasing information please contact:
Mark J. Gunderson
312.448.8645
mark.gunderson@streamrealty.com

Ben Cleveland
312.448.6221
ben.cleveland@streamrealty.com