

SUITE: 750



RSF: 8,723

AS-BUILT CONFIGURATION

| | |
|-----------------------|-----|
| OFFICES..... | N/A |
| RECEPTION..... | N/A |
| CONFERENCE ROOMS..... | N/A |
| KITCHEN..... | N/A |
| OPEN WORK AREA..... | N/A |

Not to scale, furniture and appliances not included

KEY PLAN

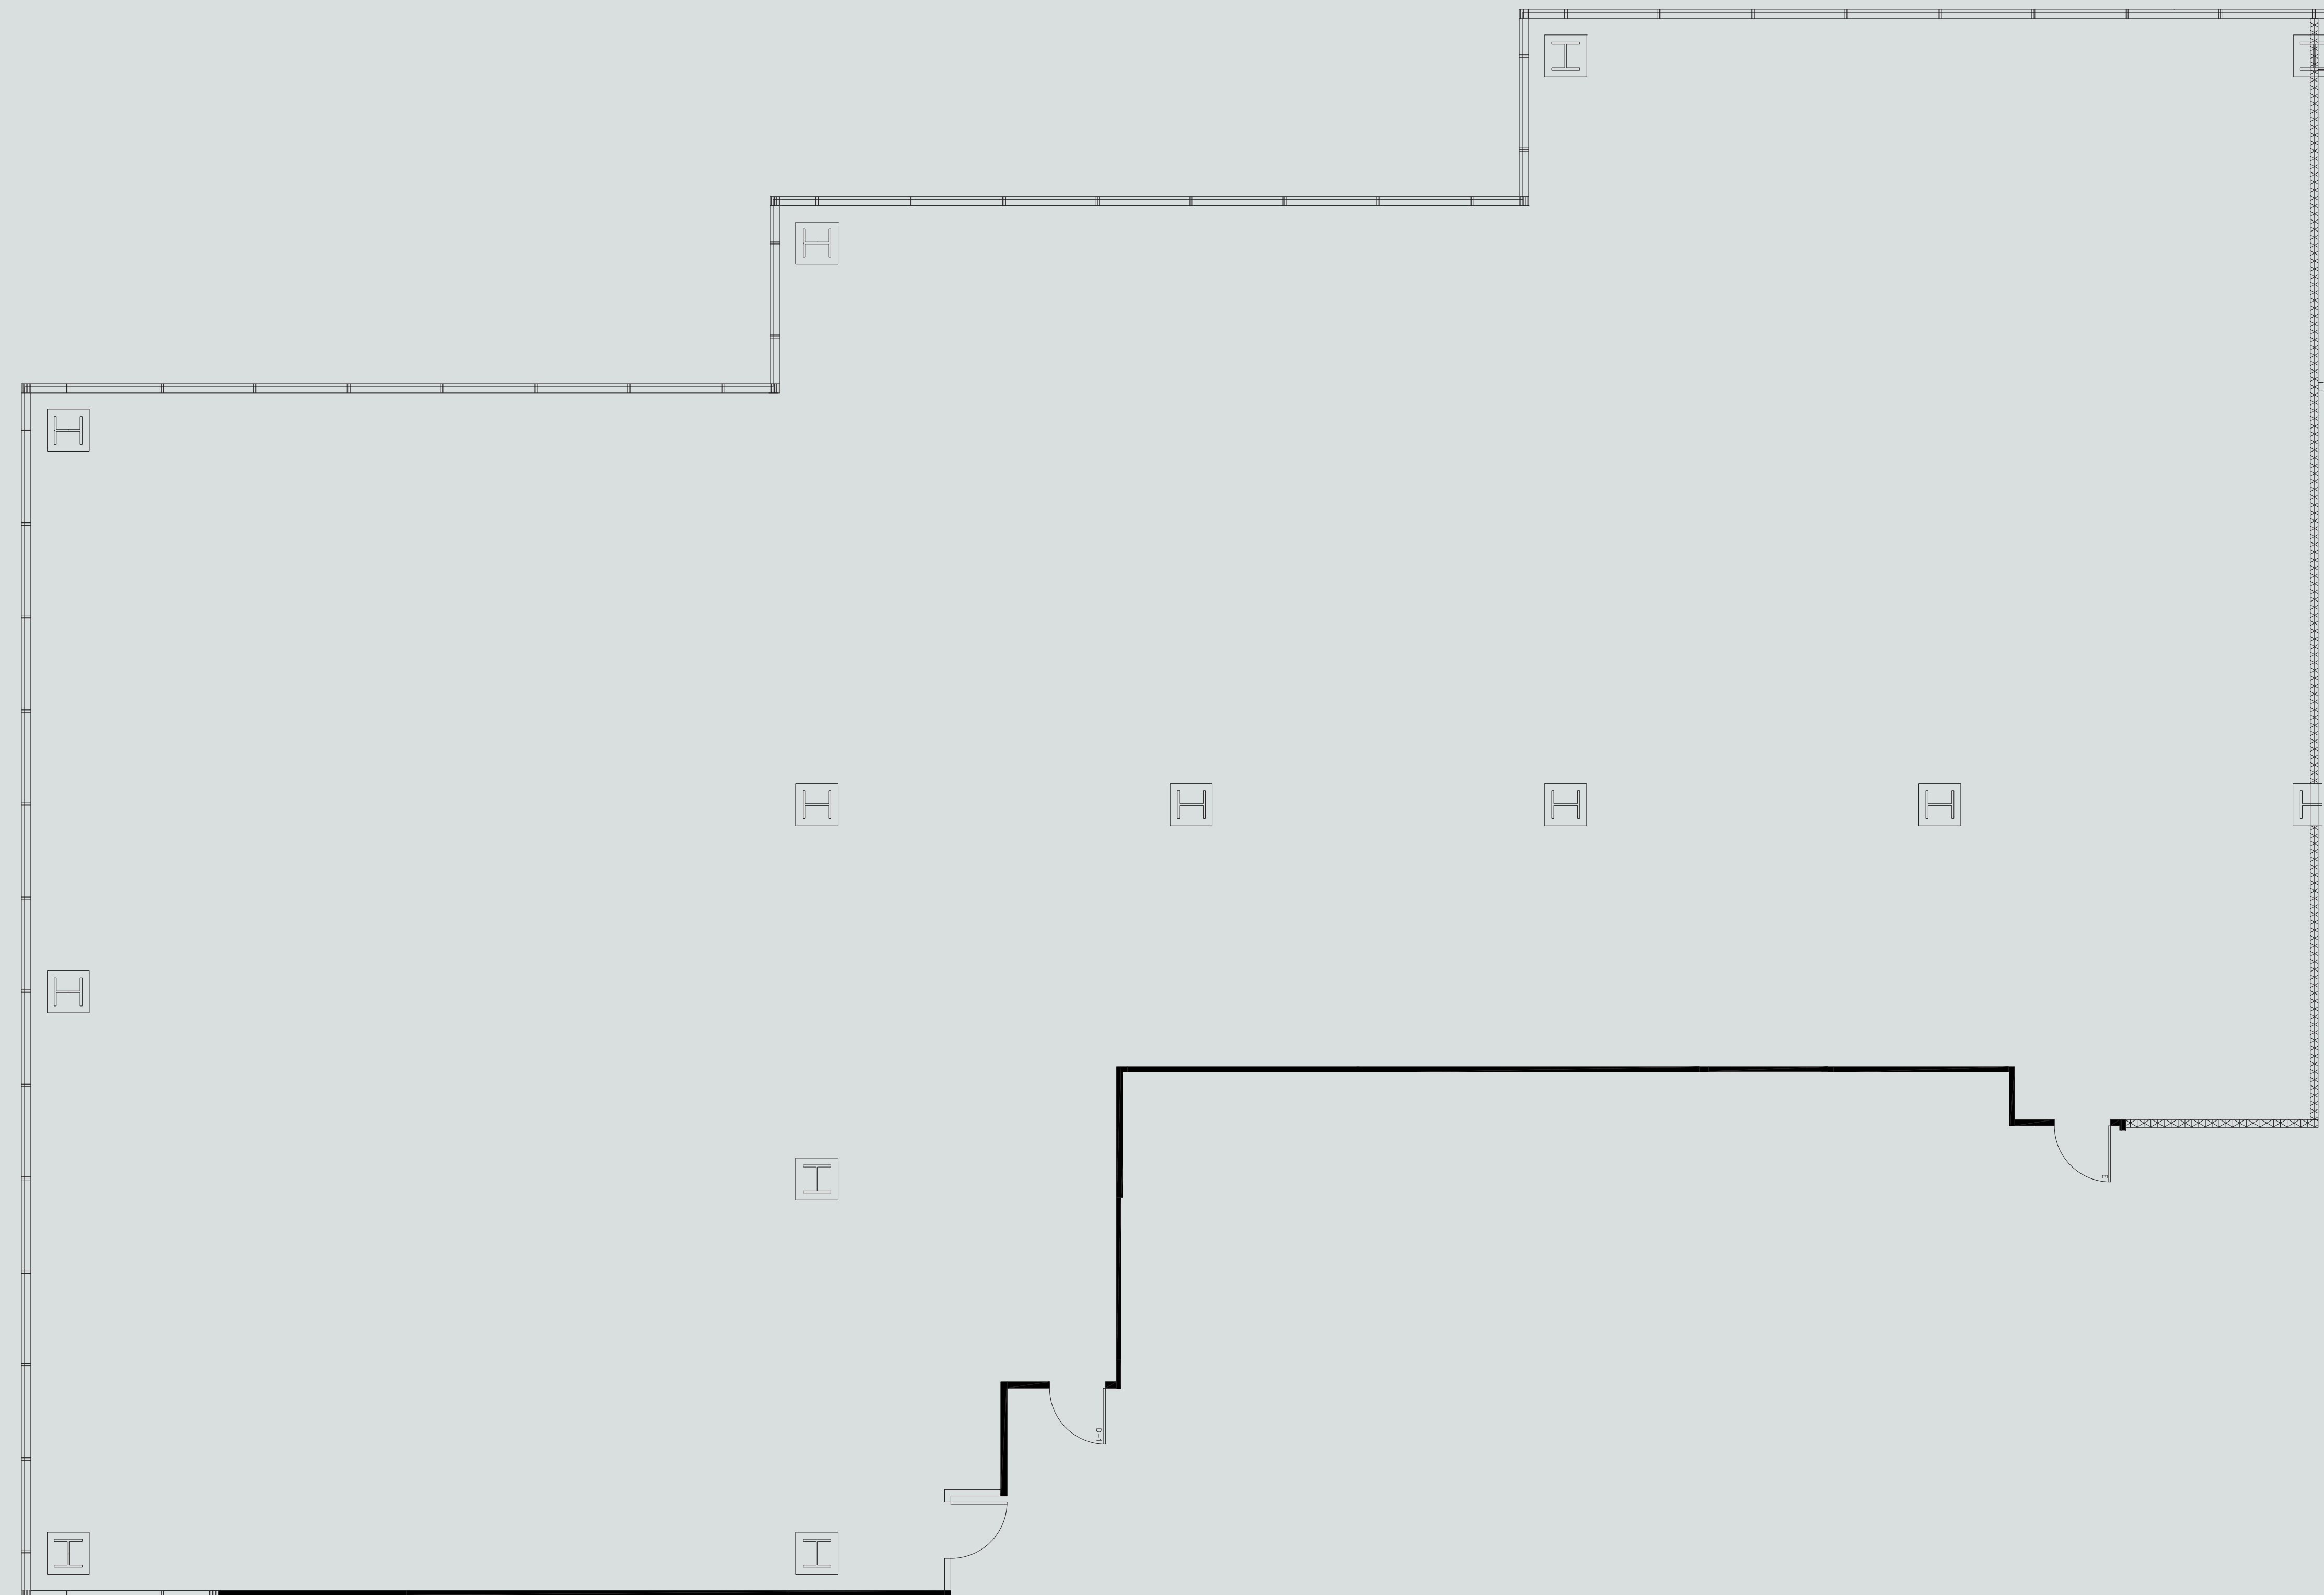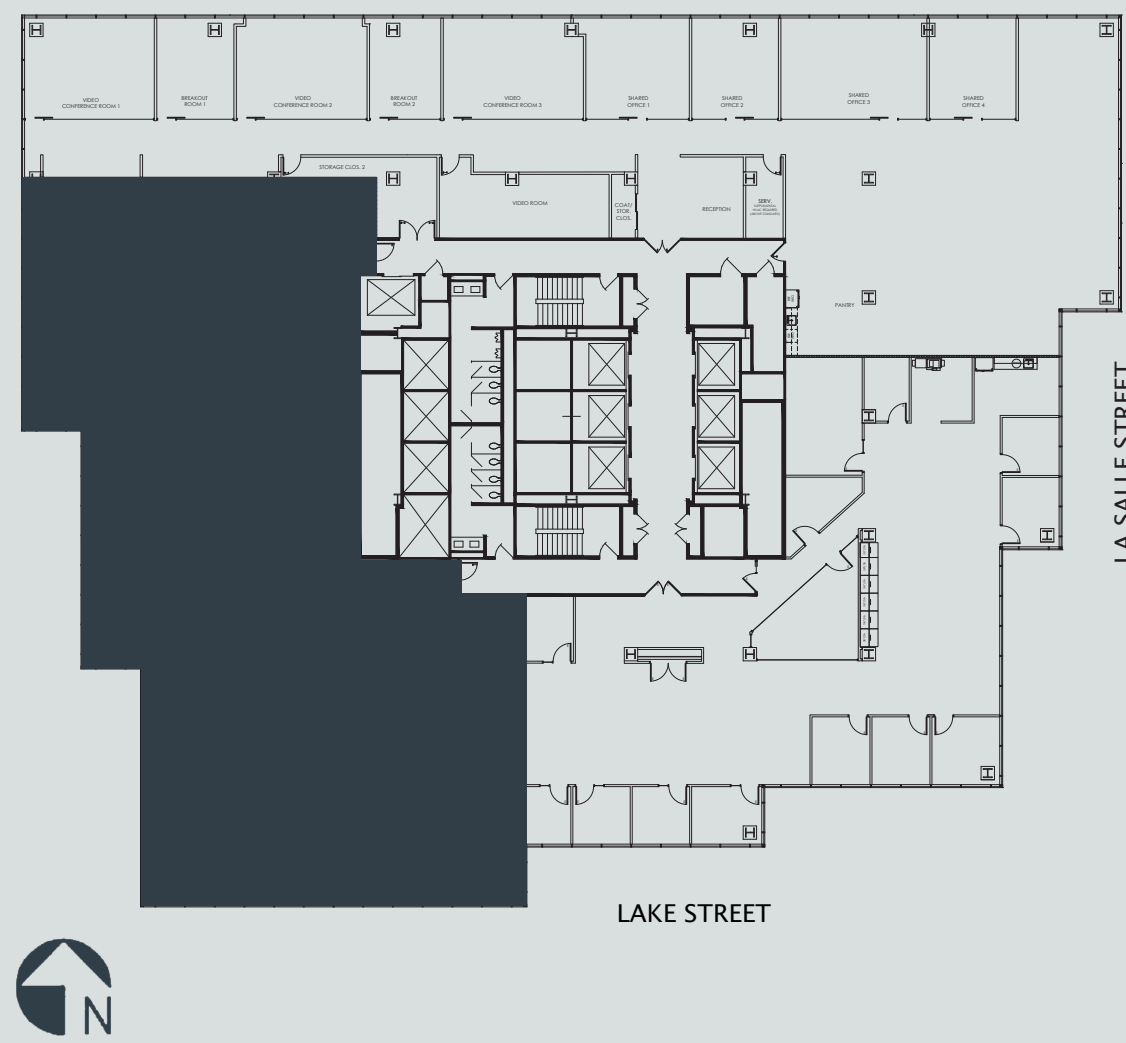

For leasing information please contact:
Mark J. Gunderson
312.448.8645
mark.gunderson@streamrealty.com

Ben Cleveland
312.448.6221
ben.cleveland@streamrealty.com