


AS-BUILT CONFIGURATION

| | |
|-----------------------|----|
| OFFICES..... | 3 |
| RECEPTION..... | 1 |
| CONFERENCE ROOMS..... | 1 |
| KITCHEN..... | 1 |
| OPEN WORK AREA..... | 70 |

Not to scale, furniture and appliances not included

KEY PLAN

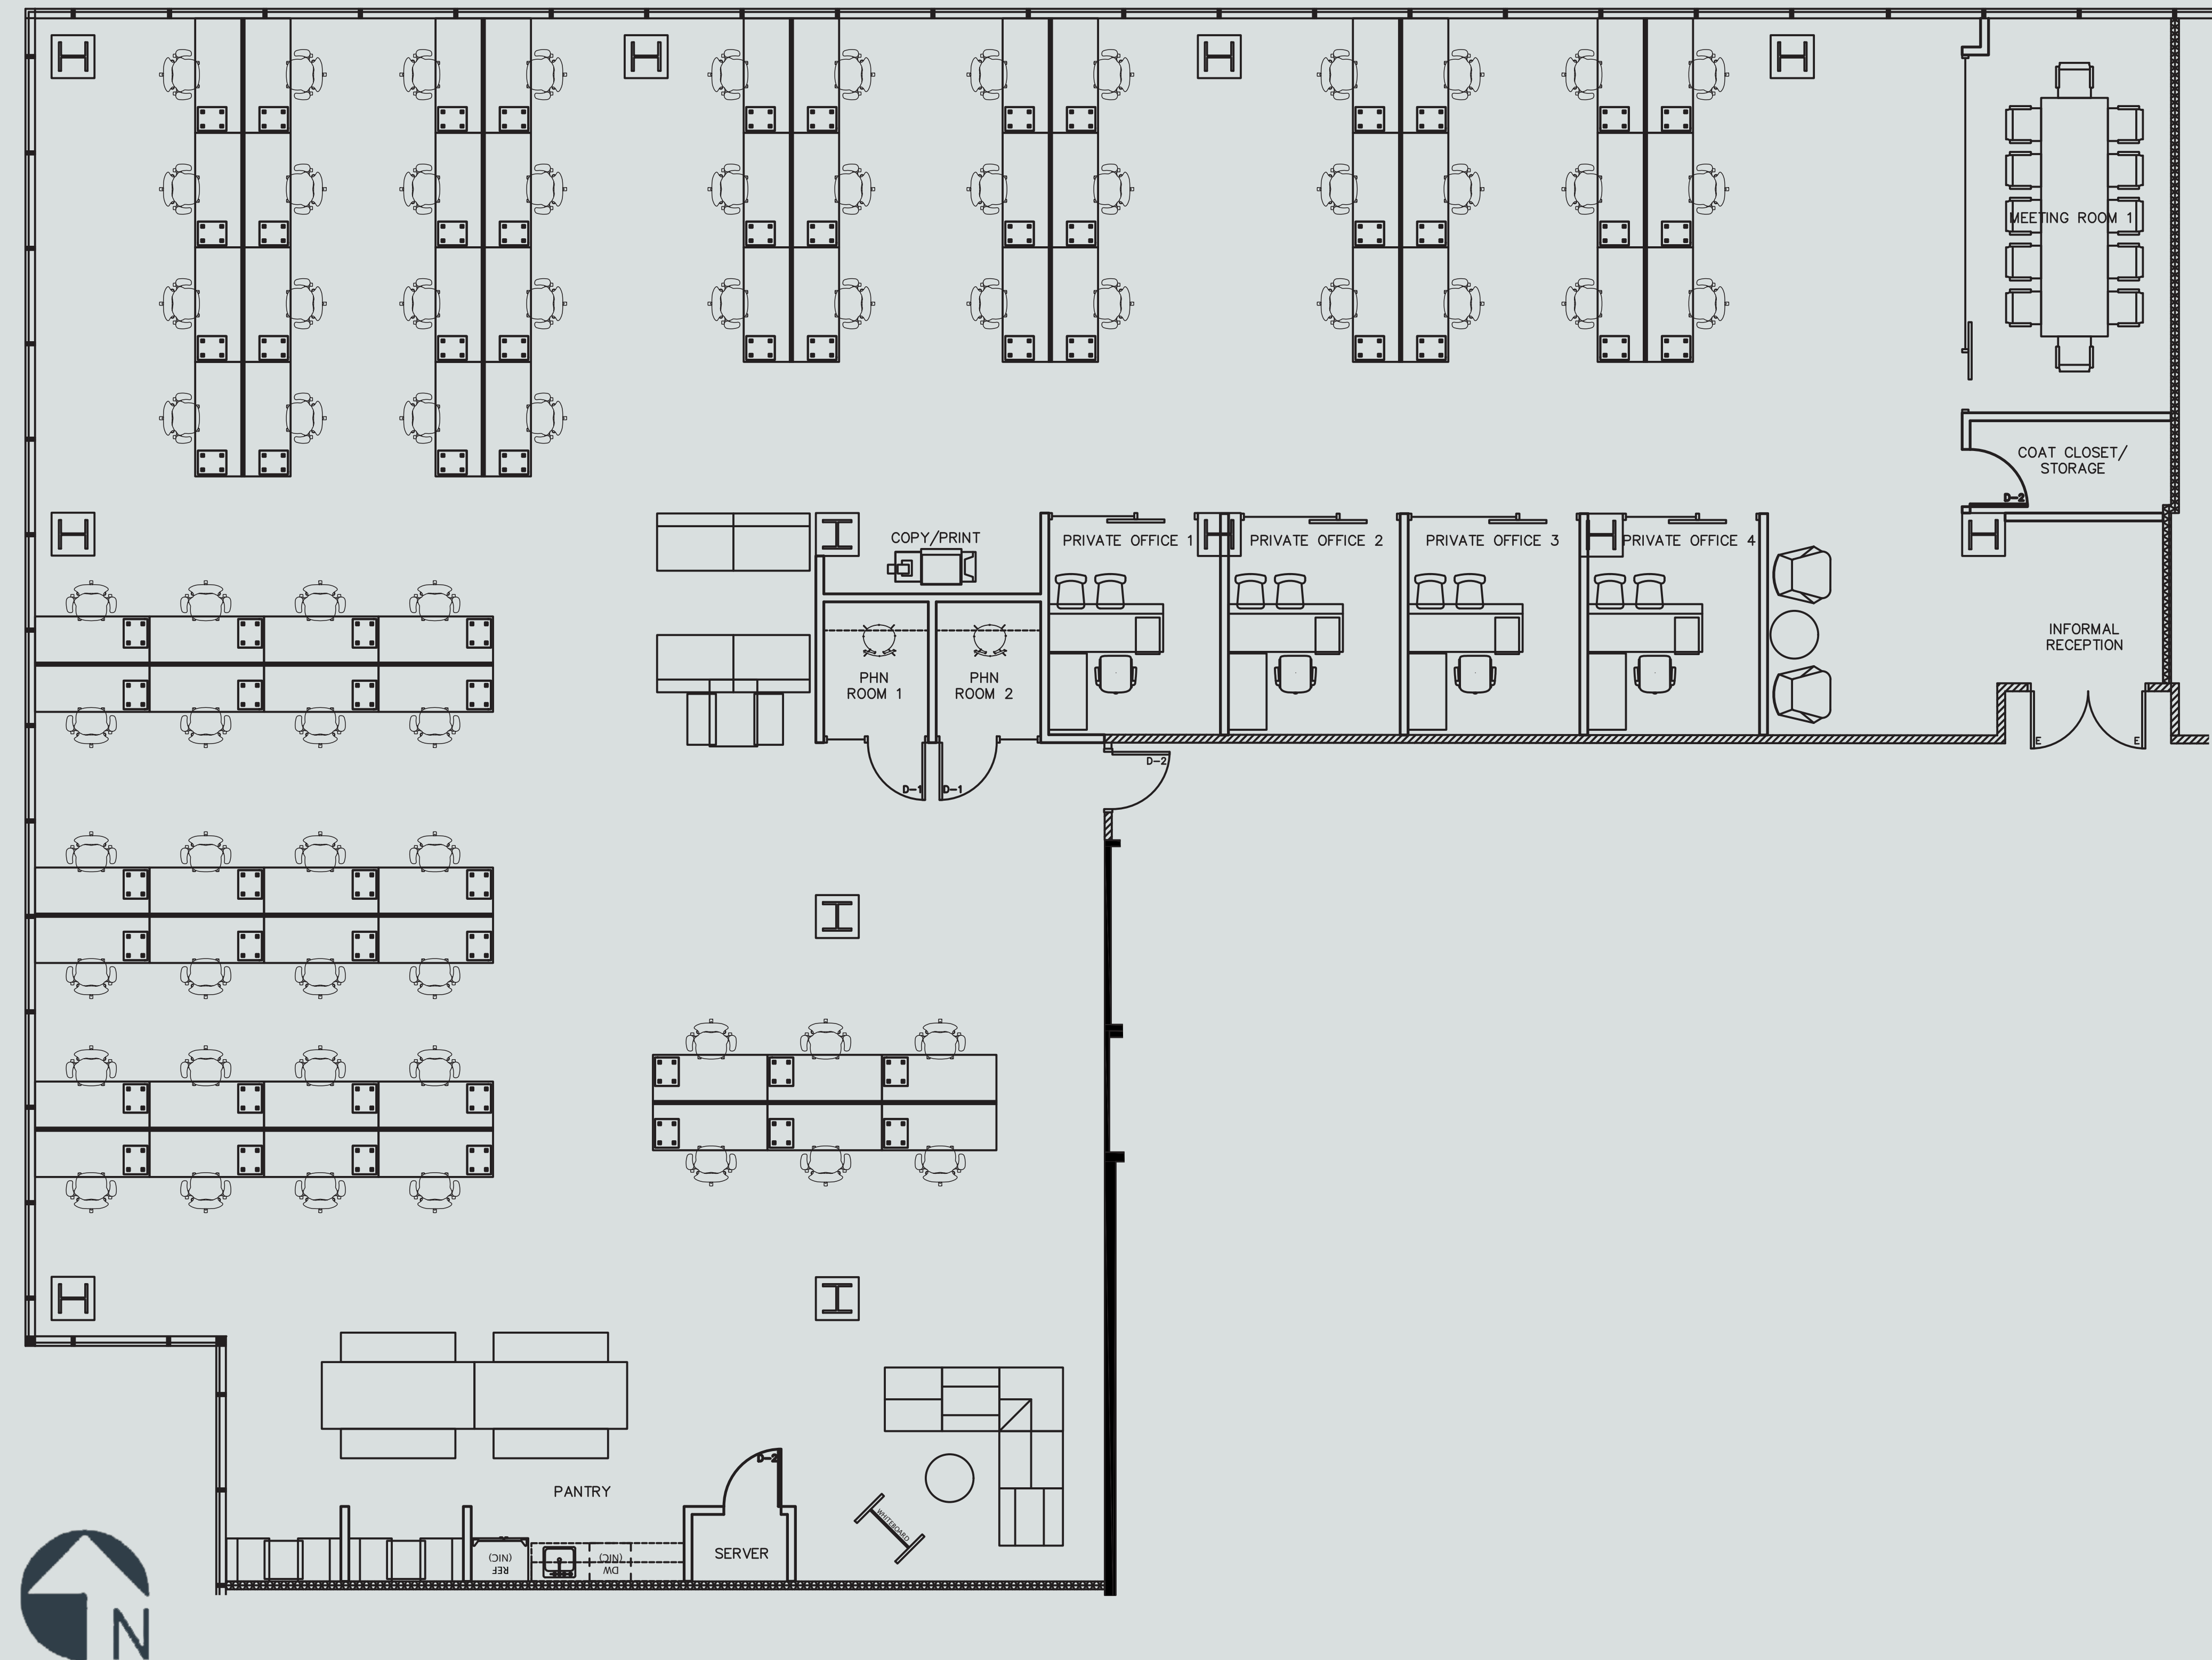

For leasing information please contact:
Mark J. Gunderson
312 819 1236 | mark.gunderson@cushwake.com

Ben Cleveland
312 819 1236 | ben.cleveland@cushwake.com