

# SUITE: 880

# RSF: 8,242 SF





## AS-BUILT CONFIGURATION

OFFICES.....	4
RECEPTION.....	1
CONFERENCE ROOMS.....	2
KITCHEN.....	1
OPEN WORK AREA.....	72

*Not to scale, furniture and appliances not included*

## KEY PLAN

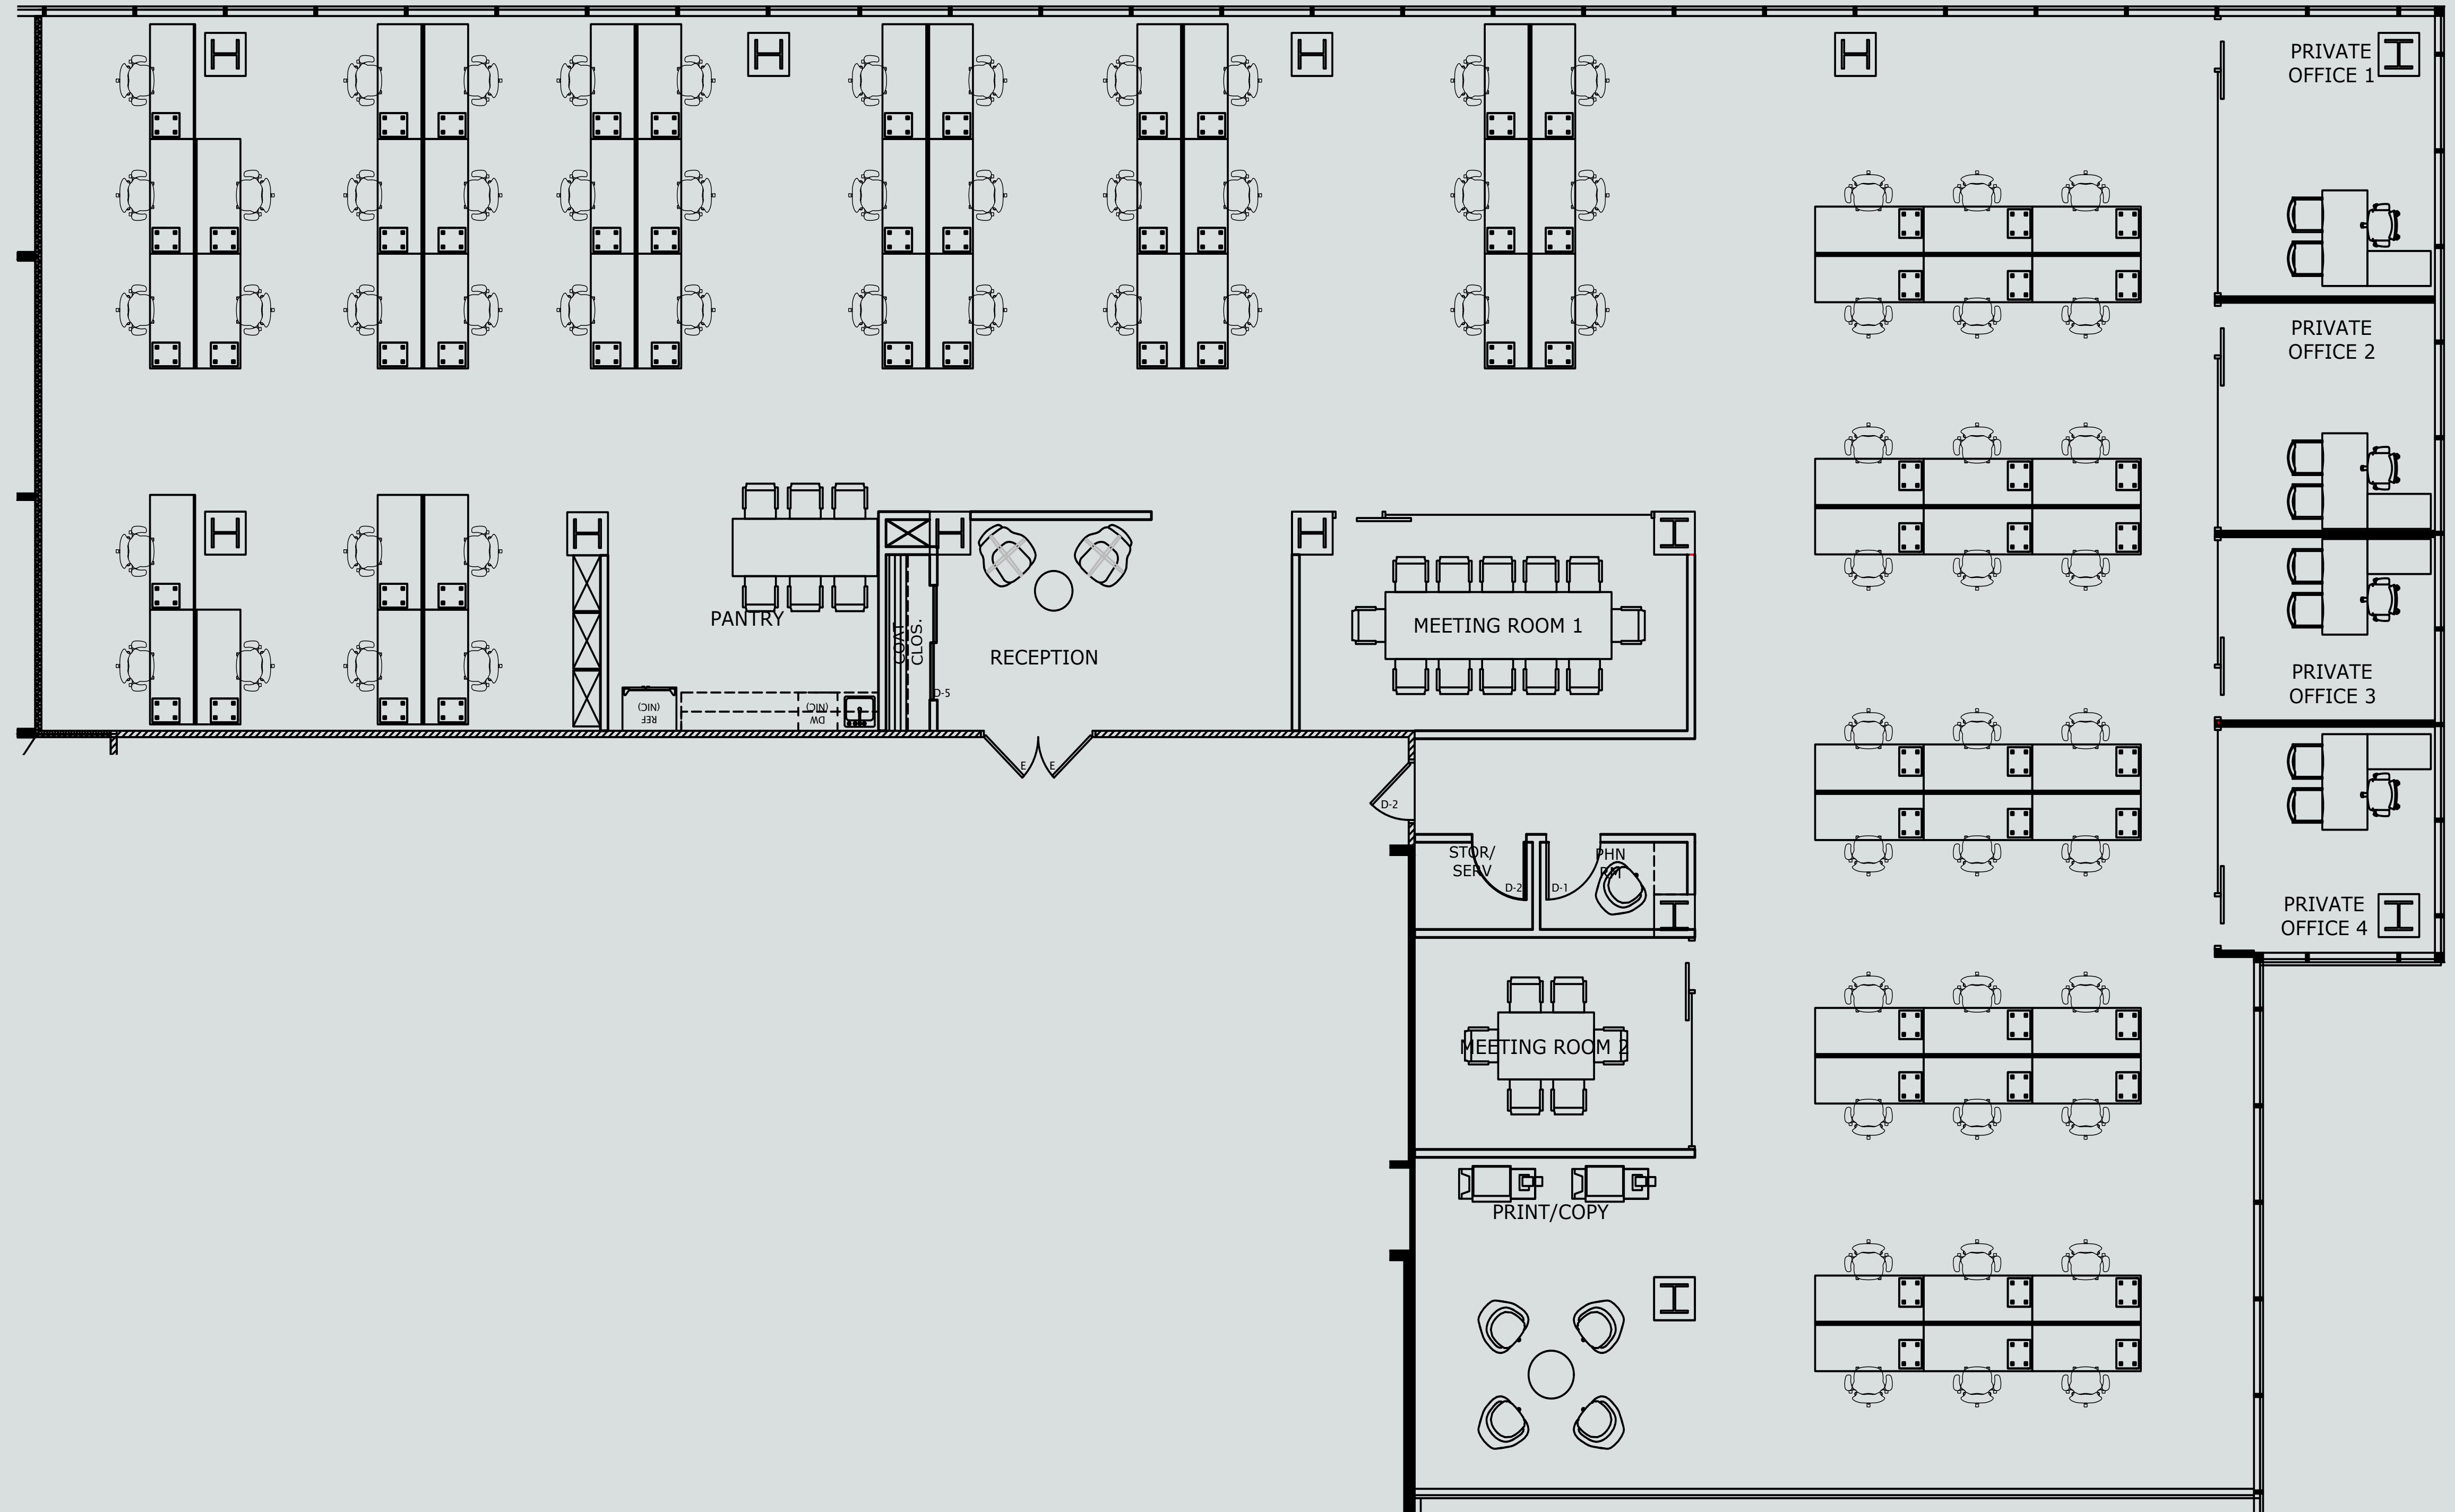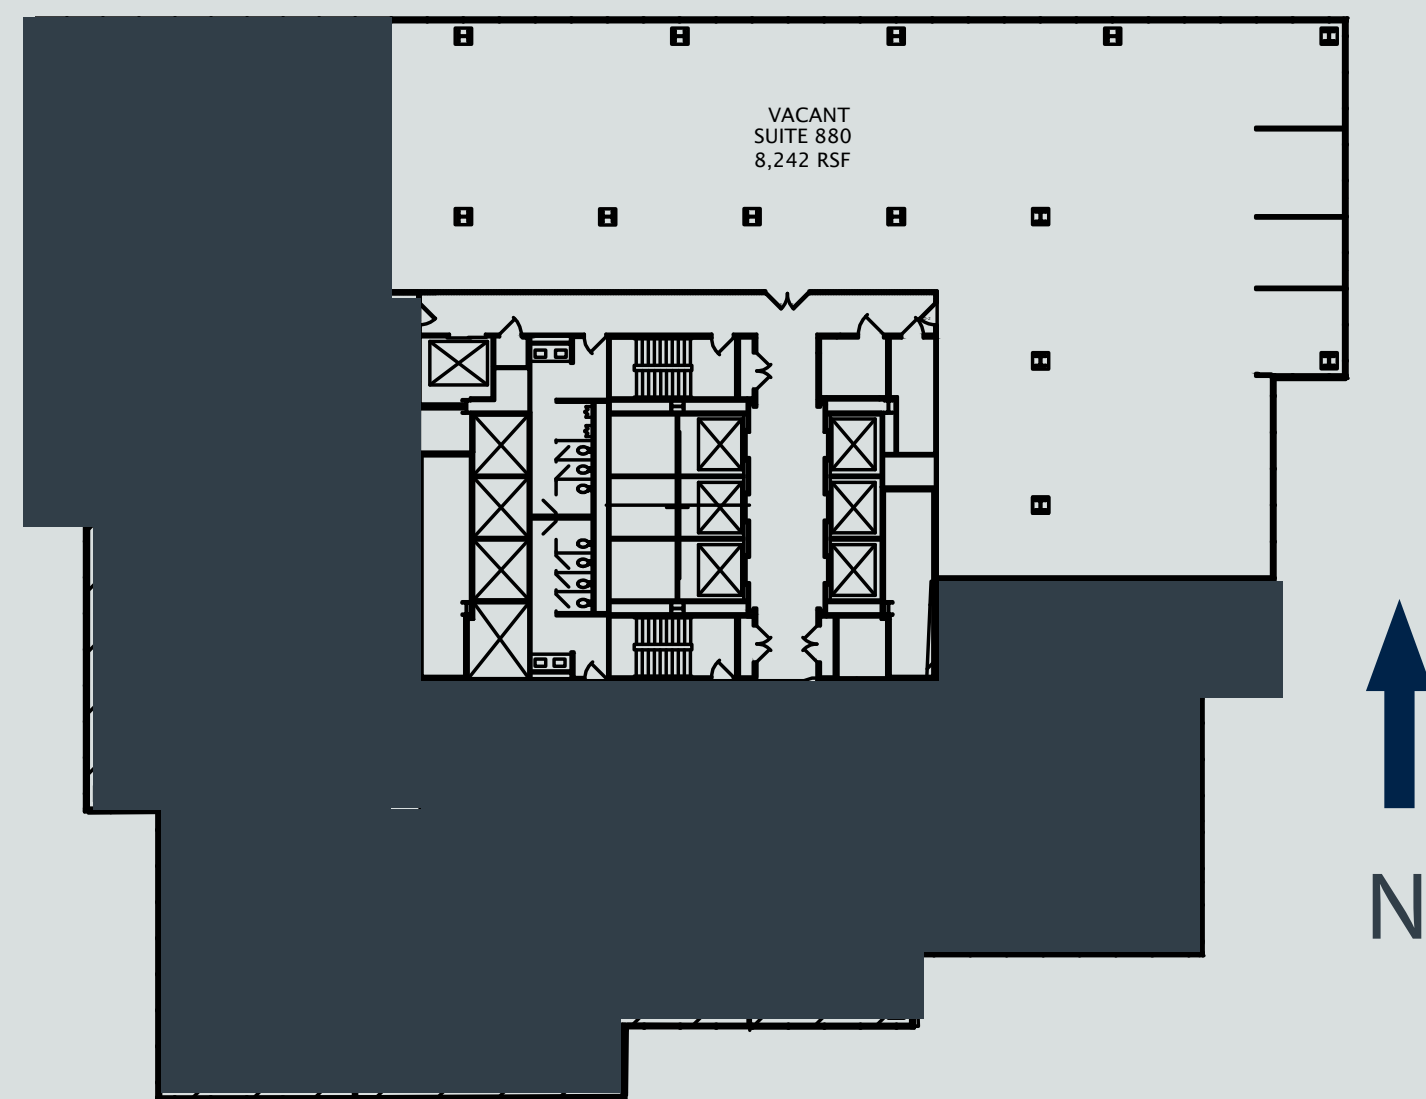

For leasing information please contact:  
Mark J. Gunderson  
312 819 1236 | mark.gunderson@cushwake.com

Ben Cleveland  
312 819 1236 | ben.cleveland@cushwake.com

