

SUITE: 3000

RSF: 24,032





AS-BUILT CONFIGURATION

OFFICES.....	42
RECEPTION.....	1
CONFERENCE ROOMS.....	5
KITCHEN.....	3
OPEN WORK AREA.....	TBD

Not to scale, furniture and appliances not included

KEY PLAN

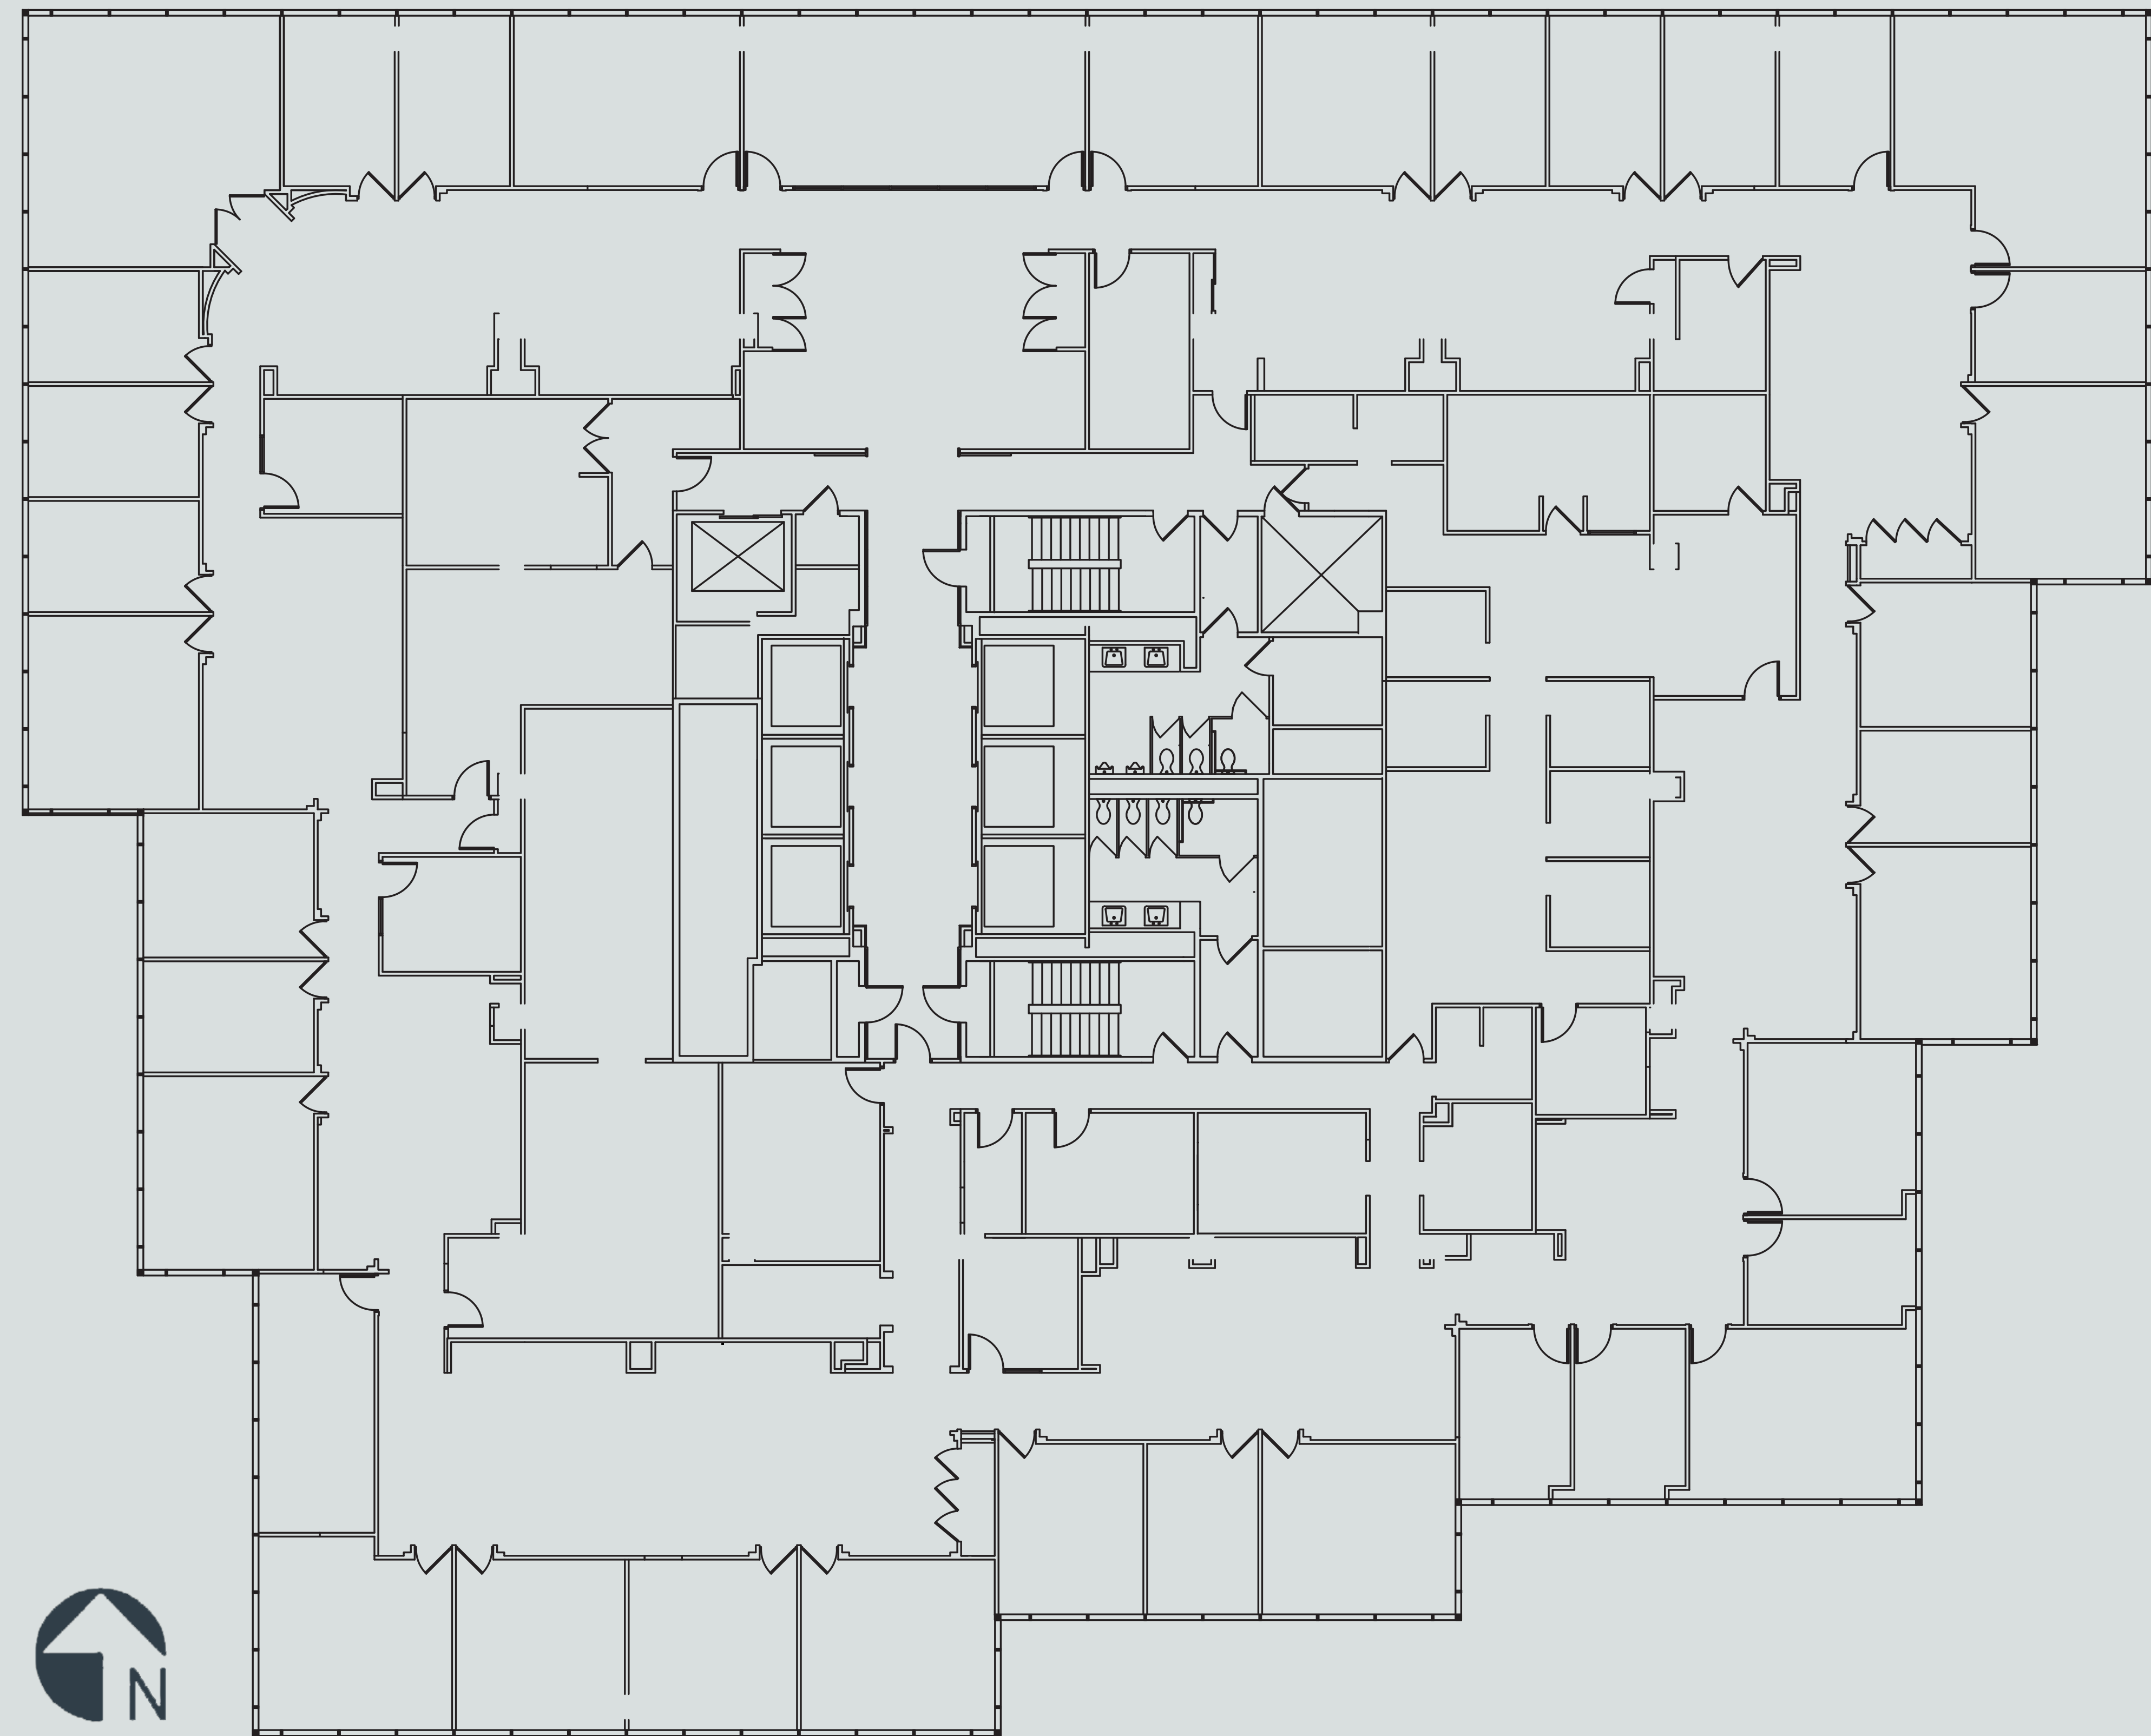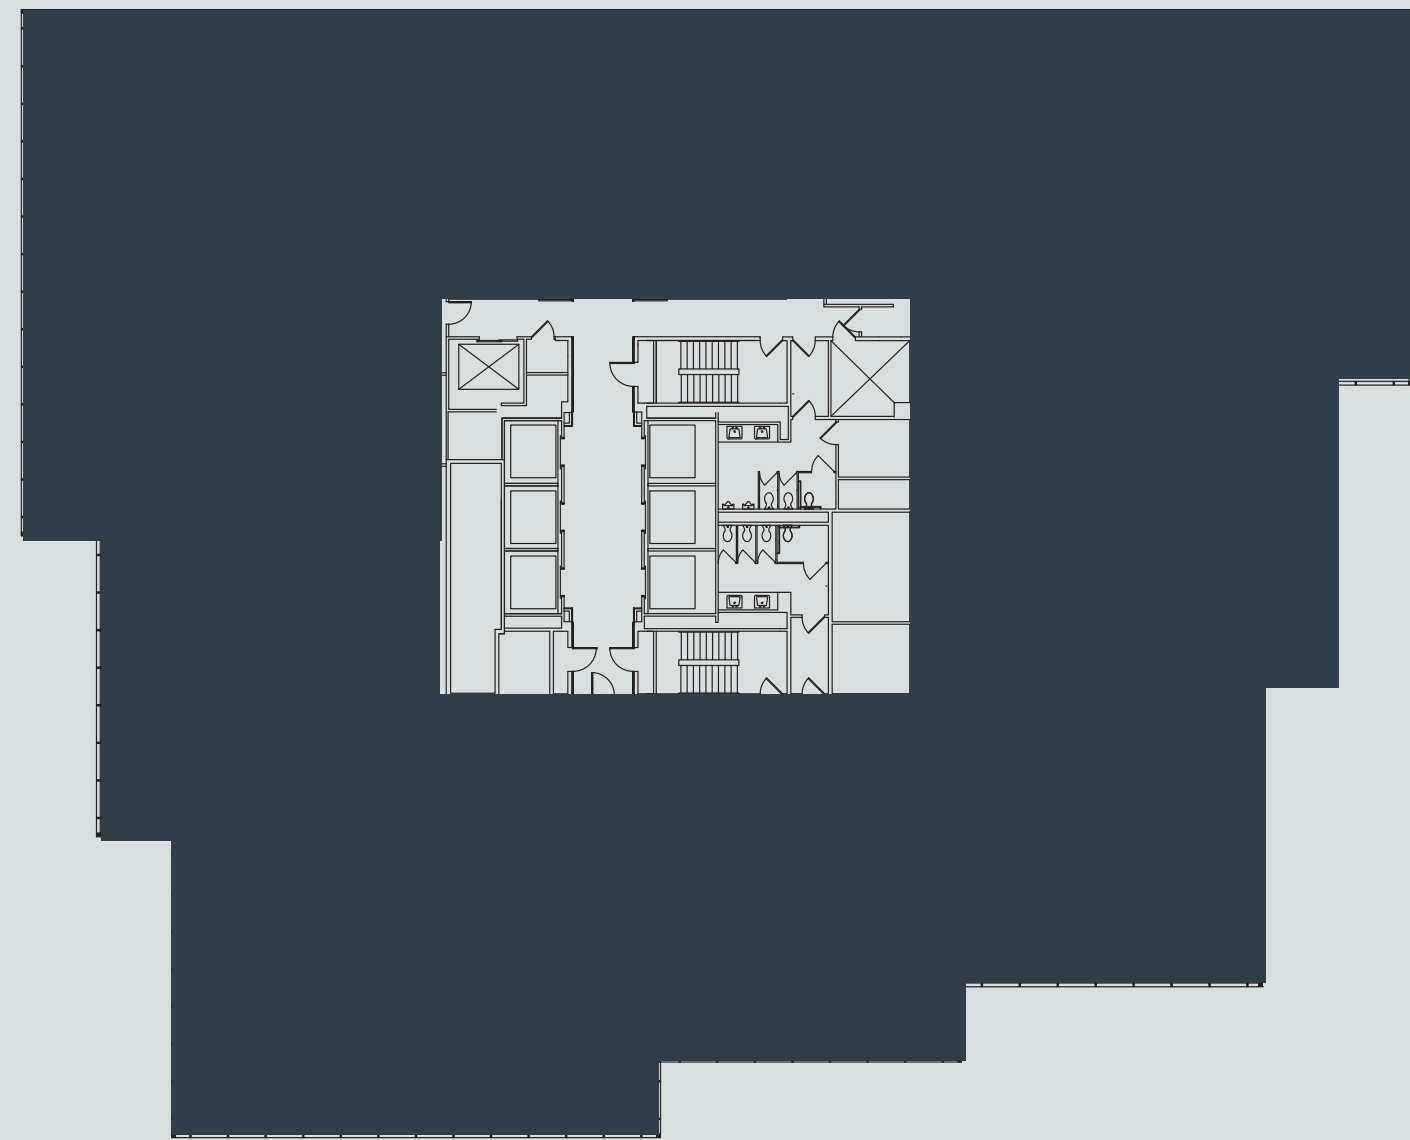

For leasing information please contact:
Mark J. Gunderson
312 819 1236 | mark.gunderson@cushwake.com

Ben Cleveland
312 819 1236 | ben.cleveland@cushwake.com

